


Section 9 Township 28 Range 5-W

Well No. #1 Viney

Company Pabco Drilling

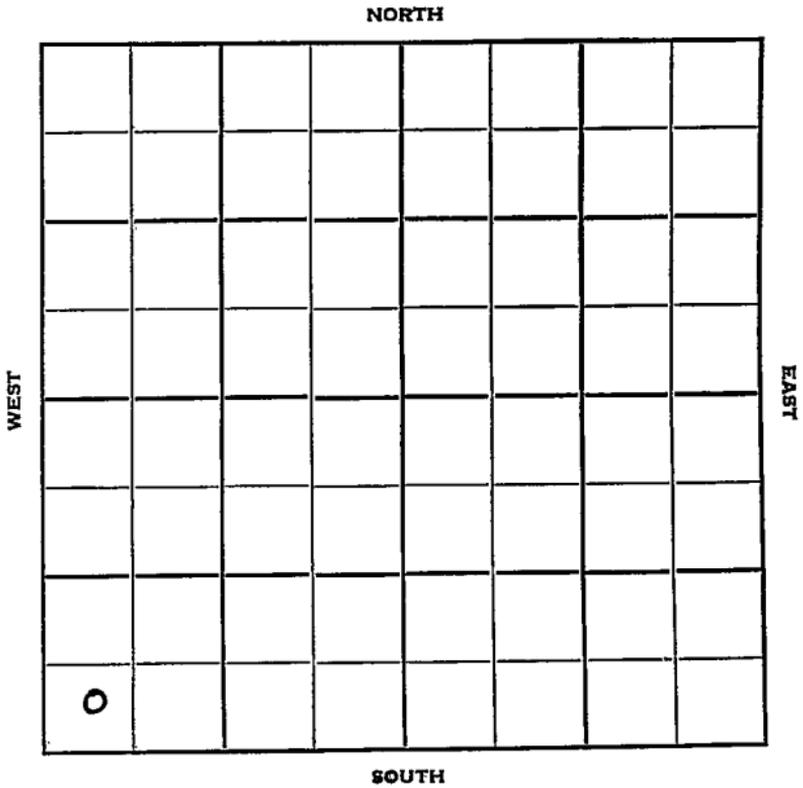

Kingman KANSAS

Sec. 9 Twp. 28 R. 5W ✓

Well No. #1 Viney Farm

Pabco Drlg. Company

Pabco Drlg. Contr. Contractor

Wildcat


 Ft. from N. Line

330' Ft. from S. Line

 Ft. from E. Line

330' Ft. from W. Line

SW SW SW

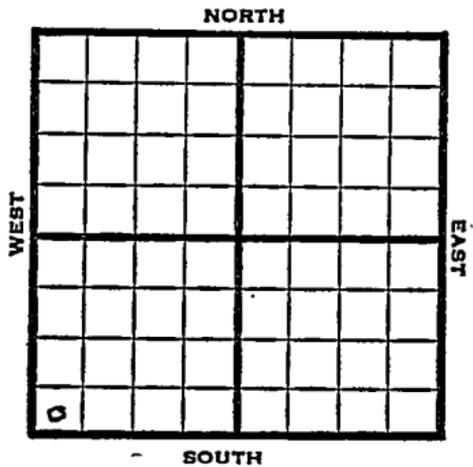

1950 Elev 1401' REPORT

11/1 Spud 10-28-50
8-5/8" @ 156'
Drlg. 1420'

1951
1/17 8 5/8" @ 156
Lans 2970 Miss chat 3761
Dol 3786
DST 3787-3807 opn 45 min rec 300' gcm
3 mcfg
DST 3805-15 opn 1 hr rec 60' gcm
60' muddy oil 290' clean oil 10' wtr
5" @ 3849
TD 3849
48/3805-11 S/1 boph 1000 A
Est 5 mcfg F/61 bo 12 hr
F/6 boph
Comp F/121 bopd
Completed
COMPLETED

County Kingman State Kansas

Sec. 9 (Blk. Twp.) 28 (Sur. Rge.) 5W Map No.

Operator Pabco Drlg.

Well No. 1 Farm Viney

Elev. Location SW SW SW

FIRST REPORT

330 Ft. From S Line SW

330 Ft. From W Line Quarter

Ist. Report NOV 1 1950

Completion

Remarks

Pabco Drlg. - Contr.

Spudding Date 10-28-50

Drlg. Data Wildcat

8 5/8" @ 156 drlg. 1420

