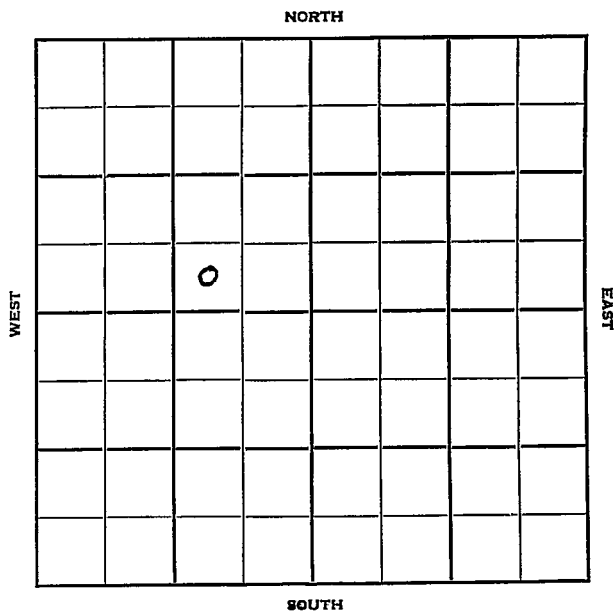


Section 9 Township 28 Range 5 WWell No. # 1 PadgettCompany Pabco Drlg.

Kingman **KANSAS**

Sec. 9 Twp. 28 R. 5W

Well No. #1 Padgett Farm

Pabco Drlg. Company

Contractor

Dewey Pool


Ft. from N. Line

330' Ft. from S. Line

Ft. from E. Line

990' Ft. from W. Line

SW SE NW

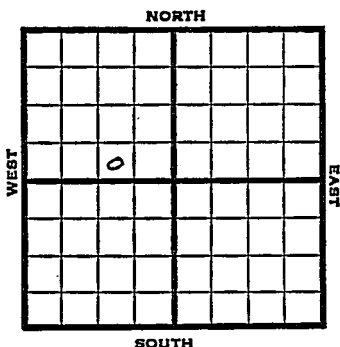

1951

Elev. 1419'

REPORT

3/14

Spud 3-8-51

8" @ 152

Drlg. 2390'

4/11

Spud 3-8-51

Oil Well TD 3812

8" @ 152

Br Lime 2957

Lans. 2974

Miss 3777

DoI 3805

TD 3812

DST 3805-12 opn 1 hr gas in 3 min

Rec. $2\frac{1}{2}$ mcfg 120' free oil

$5\frac{1}{2}$ " @ 3805 GO to 3812

F/ $3\frac{1}{2}$ boph 500 A

F/90 bo 6 hr Comp. 315 bopd 6% wtr

COMPLETED

J. E. TYRA

J. E. TYRA