

Section 9 Township 28 Range 5WWell No. #3 PadgettCompany Pabco Drlg.

NORTH

	6						

WEST

EAST

SOUTH

Kingman

KANSAS

Sec. 9 Twp. 28 R. 5W ✓

Well No. #3 Padgett Farm

Pabco Drlg. Company

Contractor

Dewey Pool

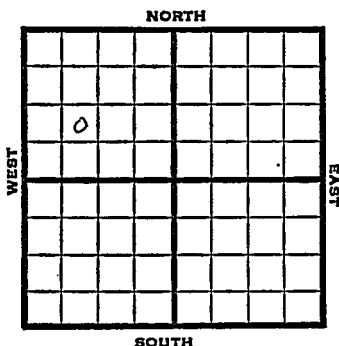
 Ft. from N. Line

990' Ft. from S. Line

 Ft. from E. Line

990' Ft. from W. Line

NE SW NW~



1951

Elev. 1420' REPORT

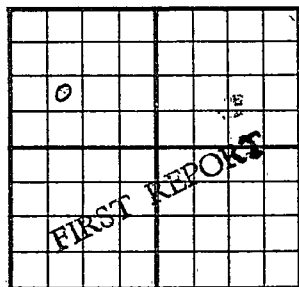
5/2

Spud 4-29-51
8" @ 150
Drlg. 1065'

7/25

Spud 4-29-51
Oil Well TD 3840
8" @ 150
KC 2974 Br Lime 2959
Lans. 2977 Miss Chert 3765
Miss dol. 3797
TD 3840 5"@ 3798
3000 A F/22 bopd
Comp. F/115 bopd

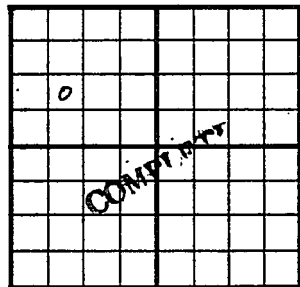
COMPLETED

County Kingman State KansasSec. 9 (Blk.) 28 (Sur. Rge.) 5W Map No.Operator Pabco Drig.Well No. 3 Farm PadgettElev. Location NE SW NW990 Ft. From S Line NW990 Ft. From W Line Quarter1st. Report MAY 2 1951

Completion

Remarks

Spudding Date 4-29-51Drig. Data Dewey Pool8" @ 150 drlg. 1065

County Kingman State KansasSec. 9 (Blk.
Twp.) 28 (Sur.
Rge.) 5W Map No.Operator Pabco Drlg.Well No. 3 Farm PadgettElev. 1420 Location NE SW NW990 Ft. From S Line NW990 Ft. From W Line Quarter

1st. Report

Completion JUL 25 1951Remarks Dewey PoolSpudding Date 4-29-51Drlg. Data Oil well TD 38408" @ 150 KC 2974 Br. lime 2959Lans. 2977 Miss. chert 3765 Mids. dol. 3797TD 3840 5" @ 3798 3000 A F/ 22 bopdComp. F/ 115 bopd

J. E. TYRA