


Section 9 Township 28 Range 5 W

Well No. # 2 Padgett

Company Pabco Drlg.

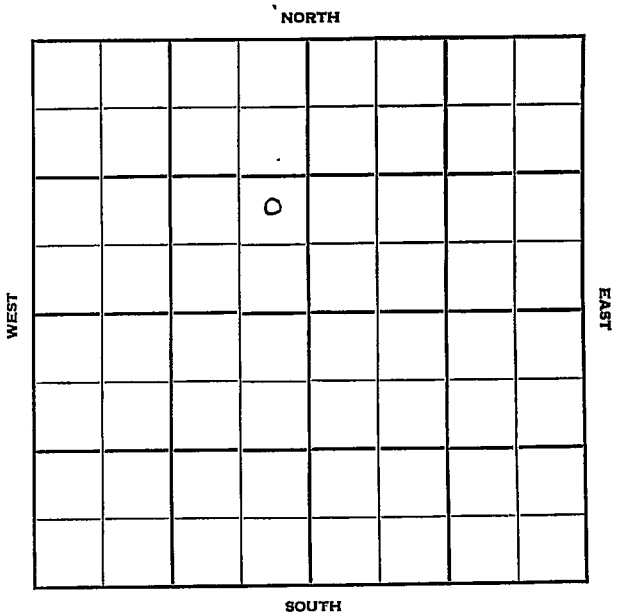

Sec. 9 Twp. 28 R. 5 W

Well No. # 2 Padgett Farm

Pagco Drlg. Company

Contractor

Dewey Pool


Ft. from N. Line

990 Ft. from S. Line

330 Ft. from E. Line

Ft. from W. Line

NE SE NW

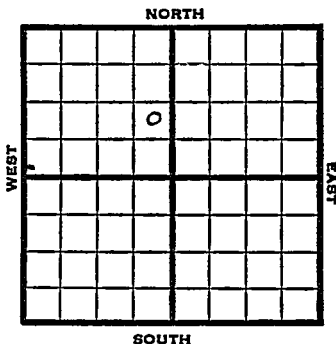

1951

Elev. 1421' REPORT

4/11

M I R

5/23

Spd 4-14-51
 Oil Well TD 3836
 8" @ 160
 Br Lime 2965 Lans. 2982
 Miss 3737 DoL. 3822
 DST 3822-36 F/oil est 10 boph
 5" @ 3822 TD 3836
 500 A · F/126 bo 8 hr ¼ mcfg
 Comp. 443 bopd

COMPLETED

County Kingman State Kansas

Sec. 9 (Blk. Twp.) 28 (Sur. Rge.) 5W Map No.

Operator Pabco Drlg.

Well No. 2 Farm Padgett

Elev. 1421 Location NE SE NW

		o			

990 Ft. From S Line NW

330 Ft. From E Line Quarter

1st. Report

Completion MAY 23 1951

Remarks Dewey Pool

Spudding Date 4-14-51

Drlg. Data Oil well TD 3836

8" @ 160 Br. lime 2965 Lans. 2982

Miss. 3737 Dol. 3822 DST 3822-36

F/ oil est 10 boph 5" @ 3822

TD 3836 500 A E/ 126 bo 8 hr.

4 mcfg Comp. 443 bopd

J. E. TYRA