


Section 9 Township 28 S Range 5 WWell No. #2 Ash *Lusk oil*Company Shallowater

NORTH

WEST

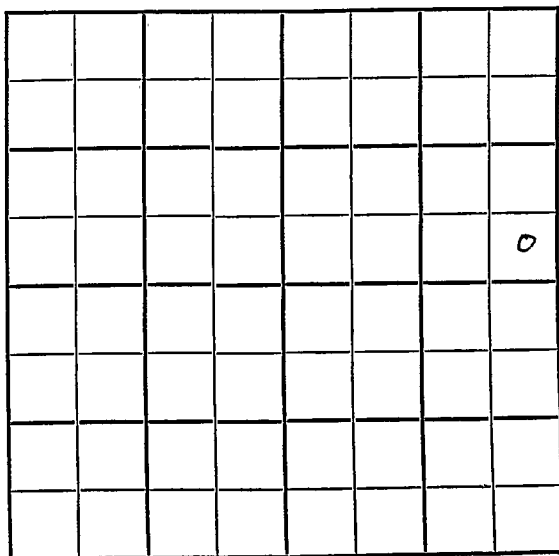

EAST

SOUTH

Kingman

KANSAS

SEC.	TWP.	R.
9	28S	5W

WELL NO.

#2 Ash

FARM

COMPANY

~~Shallowater~~
Leslie Oil

CONTRACTOR

Beardmore


Dewey

Ft. from N. Line

330 Ft. from S. Line

330 Ft. from E. Line

Ft. from W. Line

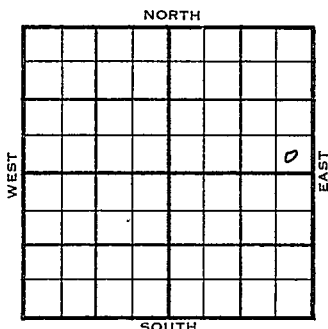

SE SE NE

	ELEVATION	REPORT
1955	1413'	

9/28 Loc

10/19 Comm 10-9-55
8 5/8" @ 150/125

BL 2972

L 2992

Ch 3782

Dolo 3813

TD 3882

DST 3805-18 open 1 hr rec 90' gcm

& 30' mw 695# DST 3826-47 open 1 hr

Rec 30' ocm 120' socm 420' msw

1180/20"

D & A

ABANDONED

SCOUT TICKET

DX-201

SEC.

TWP.

R.

9

28

5W

WELL NO.

2^d Ash

FARM

COMPANY

Leslie Oil

CONTRACTOR

CORRECTION

SE SE NE

____ FT. FROM N. LINE

330


____ FT. FROM S. LINE

330

____ FT. FORM E. LINE

____ FT. FROM W. LINE

NORTH

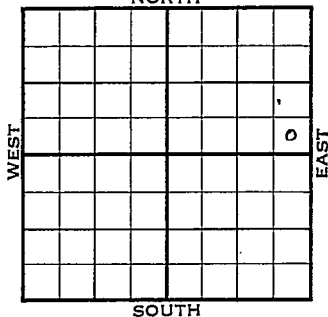

Kingman County



LOCATION



RIG UP

DRILLING AND REMARKS:

Reported
Shallow Water

RECORD

CASED IN., FT.

SAND

GAS

OIL

TOTAL DEPTH

1ST 24 HRS. NAT.

1ST 24 HRS. AFTER SHOT

GAS

CU. FT.

DRY HOLE

ABANDONED

PRODUCTION

DATE

SCOUT

OCT 12 1955

L. J. Harris

FORM 513 REV. SUNRAY ~~Beardmore sold lease to Shallowater~~

County Kingman Elev. _____
 Sec. 9 Twp. 28S Rge. 5W
 Company Shallowater
 Farm Name Ash No. 2

TOPS	DEPTH	LOG	DATUM	Loc. in Sec.
Anh.				SE SE NE
TP.				
H.				
Tr.				
Dg.				
BL.				
L.				
K.C.				Geol.
B.K.C.				Contr.
Ce.				<u>Beardmore</u>
C.				Pool
M.				<u>Dewey</u>
M.				
K.				
Mz.				
Mq.				
V.				
S.				
S.				
A.				
R.				
PE.				
G.				
TD.				

SEP 28 1955

Date Comm.

Loc.

28

Co.
Lse.
No.
Sec.
T.
R.

County Kingman Elev. 1413
 Sec. 9 Twp. 28 Rge. 5W
 Company Leslie Oil
 Farm Name Ash No. 2

TOPS	DEPTH	LOG	DATUM
Anh.			
Tr.			
H.			
Tr.			
Dg.			
BL.	<u>2972</u>		<u>1559</u>
L.	<u>2992</u>		<u>1579</u>
K.C.			
B.K.C.			
Ce.			
C.			
M.	<u>3782</u>		<u>2369</u>
M.	<u>3813</u>		<u>2406</u>
K.			
Mz.			
Ma.			
V.			
S.			
S.			
A.			
R.			
PE.			
G.			
T.D.	<u>3882</u>		

Loc. in Sec.

SE SE NE

Geol.

Contr.

Beardmore

Pool

Dewey

Date Comm. 10-9-55 OCT 19 19558 5/8" @ 150/125 DST 3805-18 open1 hr. rec. 90' gcmw & 30' mw 695#DST 3826-17 open 1 hr. Rec. 30' ocm120' socm 120' msww 1180/20"D. & A.