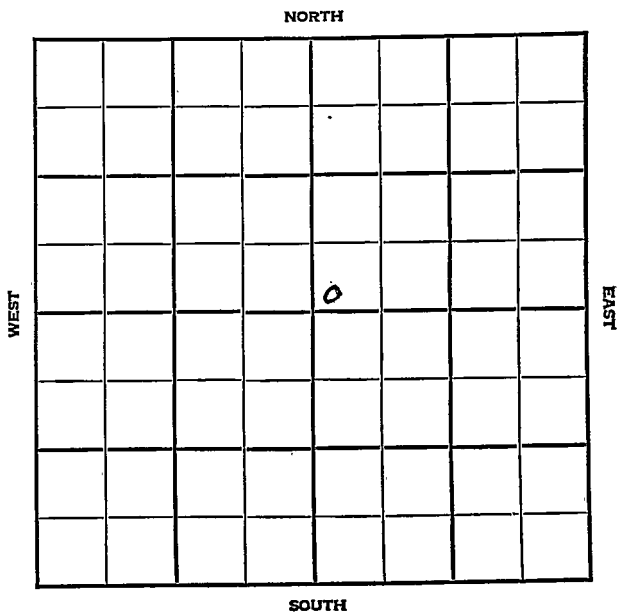


Grant

KANSASSection 9 Township 28 Range 37WWell No. #1 GrayCompany Stanolind

KANSAS

Grant

Sec. 9 Twp. 28 R. 37W

Well No. #1 Gray Farm

Stanolind Company


Hugoton

 Ft. from N. Line

150 Ft. from S. Line

 Ft. from E. Line

150 Ft. from W. Line

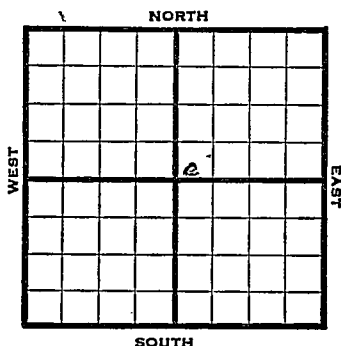

SW NE

1947

Elev. 3068' REPORT

10/8 Location

10/15 TD 2391'

10/22 10" @ 625 TD 2400
7" @ 2389 RUST

10/29 "

11/5 TD 2601'

* To run liner

11/12 226' of 5" perf. liner @ 2601'
17000 acid.

11/19 7" @ 2389'
226' of 5" Perf. Liner @ 2601'
17000 acid.
9,200,000 Gas.
400# R. Pr.
TD 2601'

COMPLETED

Map No. _____ Sec. 9 Twp. 28 R. 37W

Well No. 1 Gray

Stanolind Company

FIRST REPORT

Contractor _____

SW NE

SECTION PLAT

_____ Ft. from N. Line

150 Ft. from S. Line

_____ Ft. from E. Line

150 Ft. from W. Line

Grant County

Location X

Rig up _____

Drilling and Remarks:

RECORD

Cased _____ in., _____ ft.

Sand _____

Gas _____

Oil _____

Total Depth _____

PRODUCTION

1st 24 hrs. Nat. _____

1st 24 hrs. after shot _____

Gas _____ Cu. Ft.

Dry Hole _____

Abandoned _____


Date

OCT 8 1947 19 S. I. LEWIS Scout

KansasMap No. _____ Sec. 9 Twp. 28 R. 37WWell No. 1 GrayStanolind CompanyCOMPLETE

Contractor

SW NE

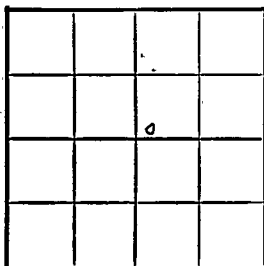E18868
SECTION PLAT

_____ Ft. from N. Line

150 Ft. from S. Line

_____ Ft. from E. Line

150 Ft. from W. LineGrant County

Location _____

Rig up _____

Drilling and Remarks:

7" C2389226' of 5' Perf lineC260117000 and C9,200,000 Gas400 # R₂

RECORD

Cased _____ in., _____ ft.

Sand _____

Gas _____

Oil _____

Total Depth 2601

PRODUCTION

1st 24 hrs. Nat. _____

1st 24 hrs. after shot _____

Gas _____ Cu. Ft.

Dry Hole _____

Abandoned _____

Date

NOV 1 9 1947 19S. J. LEWIS

Scout