


Section 9 Township 28 Range 34W

Well No. 1 Mace

Company Cities Service

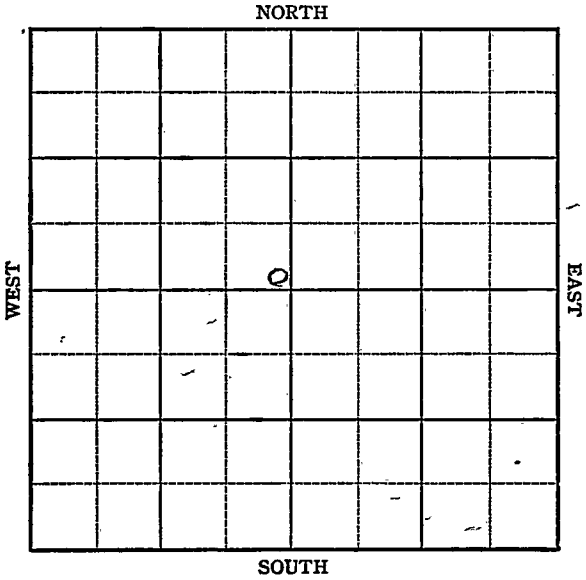


Sec. 9 Twp. 28 R. 34-W

Well No. #1 Mace Farm

Cities Service Company  
Hugoton

Ft. from N. Line  
100 Ft. from S. Line  
100 Ft. from E. Line  
Ft. from W. Line

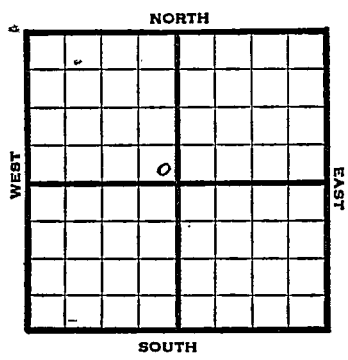

SE NW

1947 Elev. 3059' REPORT

5/14	Location
5/20	"
5/27	"
6/3	8" @ 800 WOC
6/10	TD 2830' 5" @ 2829' WOC
6/17	" "
6/24	" "
7/1	" "
7/8	TD 2830'
7/16	"
7/22	"

OVER

1947

7/30

5" @ 2829'

Perf.

3,000 acid.

20,100,000 Gas.

412# R. Pr.

TD 2830'

**COMPLETED**

Map No. \_\_\_\_\_ Sec. 9 \_\_\_\_\_ Twp. 28 \_\_\_\_\_ R. 34W \_\_\_\_\_

Well No. 1 Mace \_\_\_\_\_

\_\_\_\_\_ Cities Service \_\_\_\_\_ Company

\_\_\_\_\_ FIRST REPORT \_\_\_\_\_ Contractor

SE NW

## SECTION PLAT


\_\_\_\_\_ Ft. from N. Line

100 \_\_\_\_\_ Ft. from S. Line

100 \_\_\_\_\_ Ft. from E. Line

\_\_\_\_\_ Ft. from W. Line

Haskell County

Location \_\_\_\_\_ X \_\_\_\_\_

Rig up \_\_\_\_\_

Drilling and Remarks:

## RECORD

Cased \_\_\_\_\_ in., \_\_\_\_\_ ft.

Sand \_\_\_\_\_

Gas \_\_\_\_\_

Oil \_\_\_\_\_

Total Depth \_\_\_\_\_

## PRODUCTION

1st 24 hrs. Nat. \_\_\_\_\_

1st 24 hrs. after shot \_\_\_\_\_

Gas \_\_\_\_\_ Cu. Ft.

Dry Hole \_\_\_\_\_

Abandoned \_\_\_\_\_

Date

MAY 14 1947 19 \_\_\_\_\_

S. J. LEWIS \_\_\_\_\_ Scout

107. 18.

Misc. Small Maps	<i>[initials]</i>
Cards	<i>[initials]</i>
Tracing	<i>[initials]</i>
France Map	<del><i>[initials]</i></del>
Scarborough Map	<del><i>[initials]</i></del>
Pierce Map	<del><i>[initials]</i></del>
Geological Dept.	
Pierce Plat Book	



None

Misc. Small Maps	<input checked="" type="checkbox"/>
Cards	<input checked="" type="checkbox"/>
Tracing	<input checked="" type="checkbox"/>
France Map	<input checked="" type="checkbox"/>
Scarborough Map	<input checked="" type="checkbox"/>
Pierce Map	<input checked="" type="checkbox"/>
Geological Dept.	<input type="checkbox"/>
Pierce Plat Book	<input type="checkbox"/>