

KANSAS

Form 51-5M-7-40-Palace


Pratt

Section 9 Township 28 Range 11-W

Well No. #1 Morrison

Company Skelly

NORTH Cunningham Pool

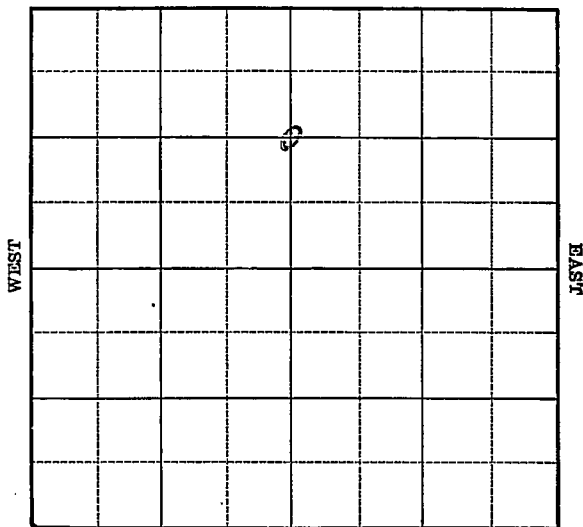

SOUTH

KANSAS


Pratt

Sec. 9 Twp. 28 R. 11-WWell No. #1 Morrison FarmSkelly Company

(Cunningham)

1320 Ft. from N. Line Ft. from S. Line2640 Ft. from E. Line Ft. from W. Line

Elev. 1773

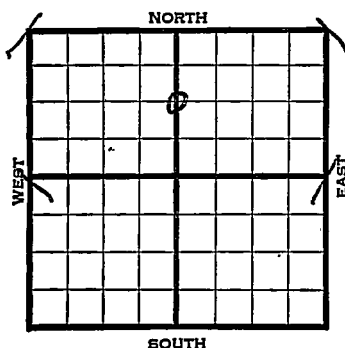

1940	REPORT
12/18	Derrick.
12/26	8" - 339' WOC.
1941	
1/2	Drilg. 2300'
1/9	Drilg. 4135'
1/16	Lans. 3580' Miss. 4032'
	Viola 4229' 5" - 4231'
	T.D. 4234' RUST.
1/23	T.D. 4255' 1000 acid.
"	Shot 30 qts. C.O.
1/29	Viola 4229'
	5" - 4231'
	T.D. 4255'
	Shot 30 qts.
	4500 acid. 1140 Butane
	9,630,000 gas.
	1380# rock pressure.
	COMPLETED

Map No. 54 Sec. 9 Twp. 28 R. 11WWell No. 1 MorrisonSkelly

Company

Contractor

FIRST REPORT

C $N\frac{1}{2}$ Sec.1320 Ft. from N. Line


_____ Ft. from S. Line

2640 Ft. from E. Line

_____ Ft. from W. Line

CUNNINGHAM POOL

SECTION PLAT

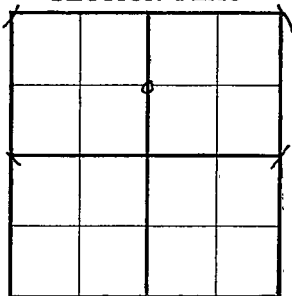

Location _____

Rig up _____

Drilling and Remarks:

Derrick

RECORD

Cased _____ in., _____ ft.

Sand _____

Gas _____

Oil _____

Total Depth _____

PRODUCTION.

1st 24 hrs. Nat. _____

1st 24 hrs. after shot _____

Gas _____ Cu. Ft.

Dry Hole _____

Abandoned _____

Date

DEC 18 1940

19

S. J. LEWIS

Scout

Map No. 57 Sec. 9 Twp. 28 R. 11WWell No. 1 L. Morrison

Skelly Oil


Company

Contractor

COMPLETED

C N $\frac{1}{2}$ Sec.

SECTION PLAT

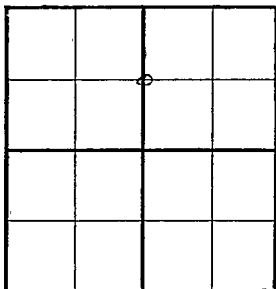1320 Ft. from N. Line

Ft. from S. Line

2640 Ft. from E. Line

Ft. from W. Line

CUNNINGHAM POOL

Location _____

Rig up _____

Drilling and Remarks:

*Viola 4229**5" @ 4231**309 to .**4500 acid**1140 Bu. tank**7,630,000 Gal**1880 Rock Cr.*

RECORD

Cased _____ in., _____ ft.

Sand _____

Gas _____

Oil _____

Total Depth *4255*

PRODUCTION

1st 24 hrs. Nat. _____

1st 24 hrs. after shot _____

Gas _____ Cu. Ft.

Dry Hole _____

Abandoned _____

Date

JAN 29 1941

19

S. J. LEWIS

Scout