


Section 9 Township 28 Range 9^W

Well No. #1 Sisters of Charity

Company Huber

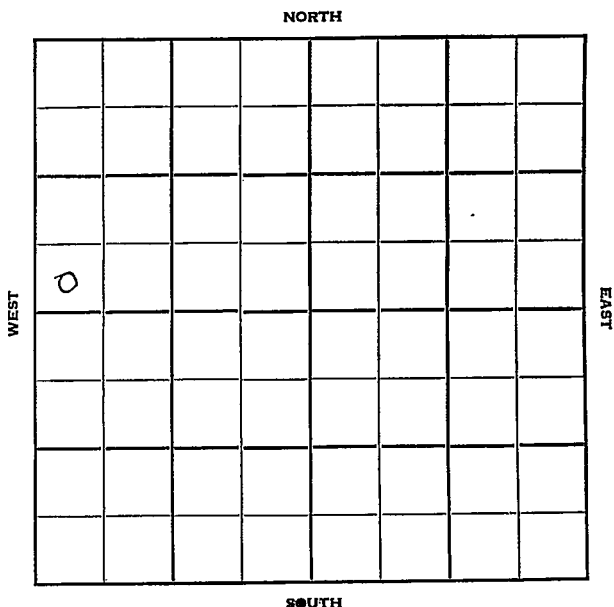

Kingman

28

9W

Sec. 9 Twp. 28 R. 9W

Well No. #1 Sisters of Charity Farm

Huber

Company

Wildcat

Contractor


 Ft. from N. Line

330' Ft. from S. Line

 Ft. from E. Line

330' Ft. from W. Line

SW SW NW

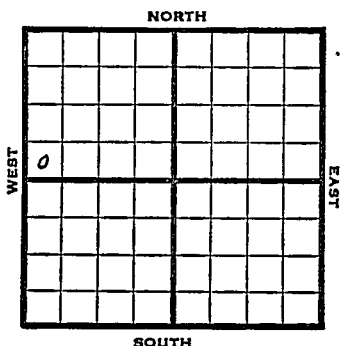

1950

Elev 1603'

REPORT

11/29

Location

1951

1/17

8" @ 319

Br line 3414

Lans 3440

DST 3712-53 opn 1 hr rec 7' sw

Miss 3987

DST 3987-96 opn 1 hr rec 90' socm

DST 3996-4010 opn 1 hr rec 1500' gcm

210' sw 30' socm

Kinderhook 4070

Viola 4284

Simp 4355

Simp sd 4374

Arb 4442-89 TD

D&A TD 4489'

ABANDONED

County Kingman State KansasSec. 9 (Blk. Twp.) 28 (Sur. Rge.) 9W Map No.Operator HuberWell No. 1 Farm Sisters of CharityElev. Location SW SW NW

0							

330 Ft. From S Line NW330 Ft. From W Line Quarter1st. Report NOV 29 1950

Completion

Remarks Cities Service DFM

Spudding Date

Drlg. Data WildcatLocation

J. E. TYRA


County Kingman State Kansas

Sec. 9 (Blk. Twp.) 28 (Sur. Rge.) 9W Map No.

Operator Huber

Well No. 1 Farm Sisters of Charity

Elev. 1603 Location SW SW NW

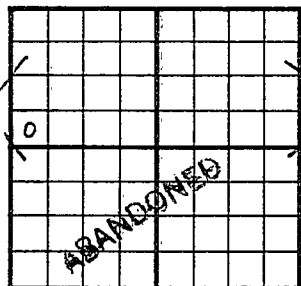

330 Ft. From S Line NW

330 Ft. From W Line Quarter

1st. Report

Completion JAN 17 1951

Remarks Wildcat

Spudding Date

Drlg. Data D & A TD 4489

8" @ 319 Br. lime 3414 Lans. 3440

DST 3712-53 open 1 hr. Rec. 7' sw

Miss. 3987 DST 3987-96 open 1 hr.

Rec. 90' socm DST 3996-4010 open 1 hr.

Rec. 1500' gcm 210' sw 30' socm

Kinderhook 4070 Viola 4284 Simp. 4355

Simp. sd. 4374 Arb. 4442-89 TD

D & A

J. E. TYRA