


DX 78-1

Pratt KANSAS

Section 1 Township 29 Range 11W

Well No. 2 Moore

Company Lorio & Sinclair

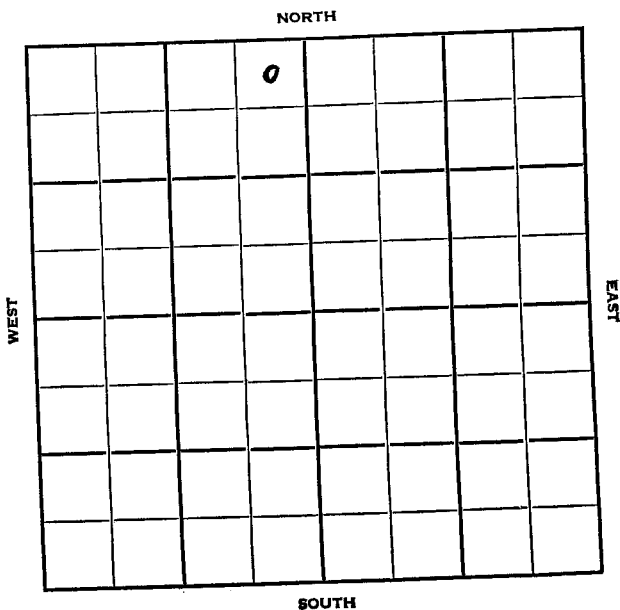

Pratt

KANSAS


SEC.	TWP.	R.
1	29	14W

WELL NO. #2 Moore FARM

COMPANY Lario & Sinclair

CONTRACTOR Buick Earl Pool

330 Ft. from N. Line
 Ft. from S. Line
 330 Ft. from E. Line
 Ft. from W. Line

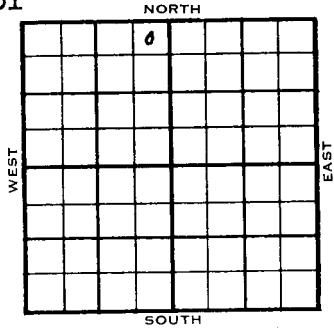

NE NE NW

	ELEVATION	REPORT
1954	1987'	

9/8 Spud 9-1-54
 8" @ 364'

10/27 Spud 9-1-54 Oil well TD 4653'
 8" @ 364' Heeb 3790 Lans 3974
 Ah. 4416 Viola 4458 Simp sh. 4520
 Simp. sd. 4524' Arb. 4636'
 DST 4231-51 open 1 hr rec 60' wtry mu
 1250#
 DST 4515-45 open 1 1/2 hr, rec 720' gass;
 oil, 120' wtr. 1250# TD 4653'
 5 @ 4651 CO 78/4530-43 S/5 BFPH
 16% wtr. 500 A 500 M-A S/6-3/4 BFP
 20% wtr. Sd-frac F/15 BO 10 to 12%
 wtr. SI 22 hrs. F/oil for 20 min.
 Uied. P/106 BO 40 BW 24 hrs.
 Comp. 111 BOPD 25% wtr.

COMPLETED

County **Pratt** State **Kansas**

Sec. **1** (Blk. Twp.) **29** (Sur. Rge.) **14W** Map No.

Operator **Lario & Sinclair**

Well No. **2** Farm **Moore**

Elev. Location **NE NE NW**

		0			
FIRST REPORT					

330 Ft. From **N** Line **NW**

330 Ft. From **E** Line Quarter

1st. Report **SEP 8 1954**

Completion

Remarks

Buick - Contr.

Spudding Date **9-1-54**

Drlg. Data **Earl Pool**

8" @ 364

