


Section 1 Township 29 Range 37W

Well No. #1 Julian

Company Hugoton Prod.

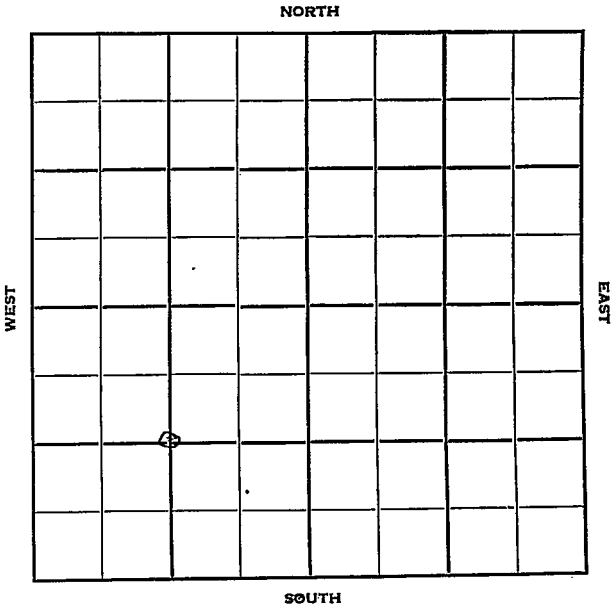

Grant

KANSAS

Sec. 1 Twp. 29 R. 37W

Well No. #1 Julian Farm

Hugoton Prod. Company

Contractor


_____ Ft. from N. Line

1310' Ft. from S. Line

_____ Ft. from E. Line

1322' Ft. from W. Line

C SW/4

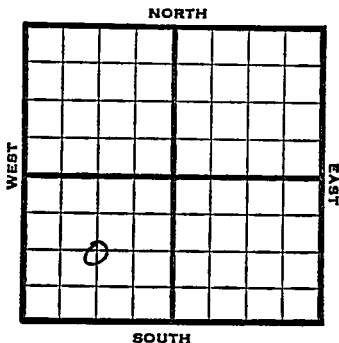

1952 Elev. 2987 REPORT

6/25 Spud 6-23-52
10" @ 560
WOC

7/2 RTD 2375' 7" @ 2364'

7/9 NR

7/17 NR

7/23 RUST

7/30 DD 2605 248' of 5" Liner

8/6 7000 A

8/13 Hol 2322 Her 2365
Kri 2383 Winfield 2453
Up Ft 2515 Low Ft 2575
TD 2605'

8/20 Spud 6-23-52
Gas Well TD 2605
10" @ 560 7" @ 2364
TD 2375 DD 2605
Hol. 2322 Her. 2365
Kri 2383 Win. 2453
Ft. Riley 2515 18,000 A
Comp. 35,912,000 gas 404#

COMPLETED

County Grant State Kansas

Sec. 1 (Blk. Twp.) 29 (Sur. Rge.) 37W Map No.

Operator Hugoton Prod.

Well No. 1 Farm Julian

Elev. _____ Location C SW/4

1310 Ft. From S Line SW

1322 Ft. From W Line Quarter

Ist. Report JUN 25 1952

Completion _____

Remarks _____

Spudding Date 6-23-52

Drlg. Data _____

10" @ 560 WOC

J. G. McGEHEE

County Grant State Kansas

Sec. 1 (Blk. Twp.) 29 (Sur. Rge.) 37W Map No.

Operator Hugoton Prod.

Well No. 1 Farm Julian

Elev. 2987 Location C SW/4

1310 Ft. From S Line SW

1322 Ft. From W Line Quarter

Ist. Report

Completion AUG 20 1952

Remarks

Spudding Date 6-23-52

Drlg. Data Gas well TD 2605

10" @ 560 7" @ 2364 TD 2375 DD 2605

Hol. 2322 Her. 2365 Kri. 2383

Win. 2453 Ft. Riley 2515 18000 A

Comp. 35,912,000 gas 404#