


Section 1 Township 29 Range 35-W

Well No. #1, W. B. Miller

Company Columbian Fuel

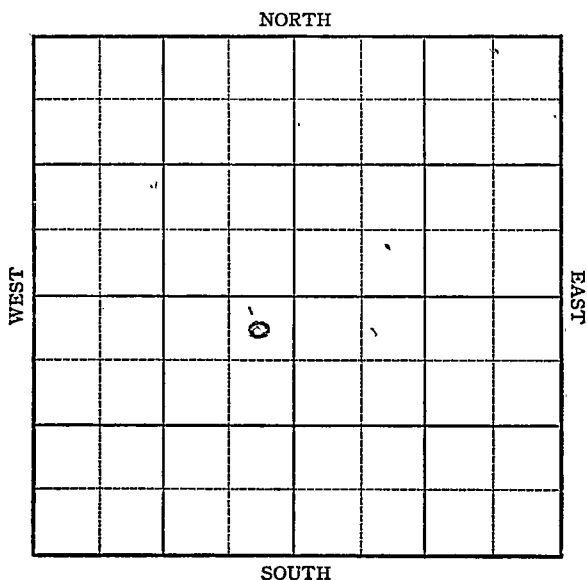

KANSAS

Grant

Sec. 1 Twp. 29 R. 35W

Well No. #1 W. B. Miller Farm

Columbian Fuel Company


Hugoton Pool

100 Ft. from N. Line

Ft. from S. Line

100 Ft. from E. Line

Ft. from W. Line

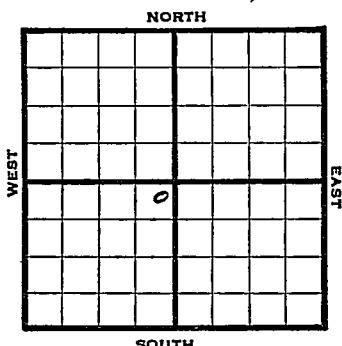

NE SW

1946 Elev. 3021 REPORT

10/23	10" @ 560'		
	WOC		
10/29	Dr1g 2575'		
11/6	TD 2582'		
	7" @ 2575, RUST		
11/12	" "		
11/20	Dr1g 2600'		
11/27	TD 2772'		
	202' of 5" perf liner @ 2772'		
12/3	TD " "	"	"
12/10	"	"	"
12/17	"	"	"

1947

1/4 TD 2772' 202' of 5"
Perf liner @ 2772'

1/8 " " "

1/15 15000 Acid

1/21 " "

2/12 7" @ 2575'
202' of 5" Perf liner @ 2772
15,000 Acid
14,752,000 Gas
420# R Pr
TD 2772'

COMPLETED

KANSAS

Hugoton Pool

Form 26 200 Bks. 10-46 Petrol

Kansas

Map No. _____ Sec. 1 Twp. 29 R. 35WWell No. 1 W. B. MillerColumbian Fuel Company

FIRST REPORT

Contractor _____

NE SW

SECTION PLAT

100 Ft. from N. Line

_____ Ft. from S. Line

100 Ft. from E. Line

_____ Ft. from W. Line

	o		

Grant County

Location _____

Rig up _____

Drilling and Remarks:

10" @ 560 WOC

RECORD

Cased _____ in., _____ ft.

Sand _____

Gas _____

Oil _____

Total Depth _____

PRODUCTION

1st 24 hrs. Nat. _____

1st 24 hrs. after shot _____

Gas _____ Cu. Ft.

Dry Hole _____

Abandoned _____

Date

OCT 23 1946

19

S. J. LEWIS

Scout

KANSAS
Kansas

Hugoton Pool

Map No. _____ Sec. 1 Twp. 29 R. 35WWell No. 1 W. B. MillerColumbian Fuel

Company

COMPLETE

Contractor

NE SW

E 13821
SECTION PLAT100 Ft. from N. Line

_____ Ft. from S. Line

100 Ft. from E. Line

_____ Ft. from W. Line

	4		

Grant County

Location _____

Rig up _____

Drilling and Remarks:

7" @ 2575262' of 5" gas line@ 277215000 cu. ft.14, 752, 000 Gas420 # R R

RECORD

Cased _____ in., _____ ft.

Sand _____

Gas _____

Oil _____

Total Depth 2772

PRODUCTION

1st 24 hrs. Nat. _____

1st 24 hrs. after shot _____

Gas _____ Cu. Ft.

Dry Hole _____

Abandoned _____

Date

FEB 12 1947 19S. J. LEWIS

Scout