
FORM 51 25M 8-50 WESTERN Haskell KANSAS

Section 1 Township 29 Range 33W

Well No. #1 Jaquart

Company National Assoc. Pet.

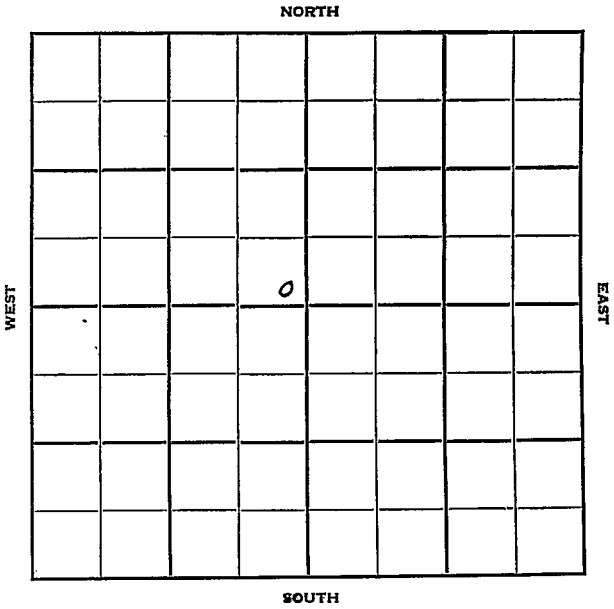

FORM 252-B
10M 10-50 PETROL

Haskell

KANSAS

Sec. 1 Twp. 29 R. 33W

Well No. #1 Jaquart Farm

National Assoc. Pet. Company

Contractor


Ft. from N. Line

150' Ft. from S. Line

150' Ft. from E. Line

Ft. from W. Line

SE NW

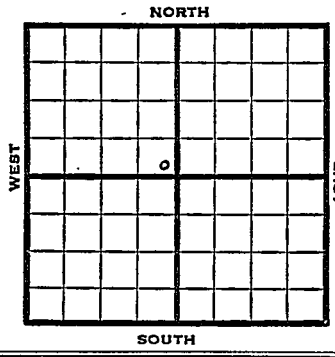

1951	Elev. 2944 REPORT
10/24	Spud 10-20-51 8" @ 617 WOC
1952 2/6	TD 2725 1000 A PB 2697 156/2660-86 78/2538-51 14,000 A
2/13	NR
2/20	"
2/27	Spud 10-20-51 Gas Well TD 2725 8" @ 617 Her. 2637 Kri. 2660 Win. 2710 5" @ 2714 TD 2725 1000 A PB 2697 156/2660-86 78/2638-51 14,000 A Comp. 7,890,000 gas COMPLETED

FORM 275 FOR SALE BY KANSAS BLUE PRINT CO.


County Haskell State Kansas

Sec. 1 (Blk. Twp.) 29 (Sur. Rge.) 33W Map No.

Operator National Assoc. Pet.

Well No. 1 Farm Jaquart

Elev. Location SE NW

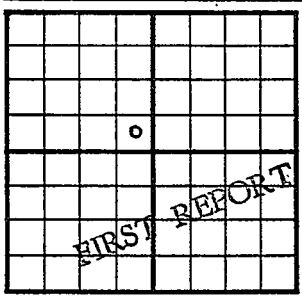

150 Ft. From S Line NW

150 Ft. From E Line Quarter

1st. Report OCT 24 1951

Completion

Remarks

Spudding Date 10-20-51

Drlg. Data

8" @ 617 WOC

J. E. TYRA

FORM 275 FOR SALE BY KANSAS BLUE PRINT CO.


County Haskell State Kansas

Sec. 1 (Blk. Twp.) 29 (Sur. Rge.) 33W Map No.

Operator National Assoc.Pet.

Well No. 1 Farm Jaquart

Elev. 2944 Location SE NW

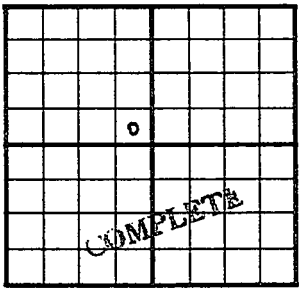

150 Ft. From S Line NW

150 Ft. From E Line Quarter

1st. Report

Completion FEB 27 1952

Remarks

Spudding Date 10-20-51

Drlg. Data Gas well TD 2725

8" @ 617 Her. 2637 Kri. 2660

Win. 2710 5" @ 2714 TD 2725

1000 A PB 2697 156/ 2660-86

78/ 2638-51 14000 A

Comp. 7,890,000 gas

J. G. McGEHEE