


Section 1 Township 29 Range 40W

Well No. 1 Julian "B"

Company Stanolind

Hugoton

NORTH

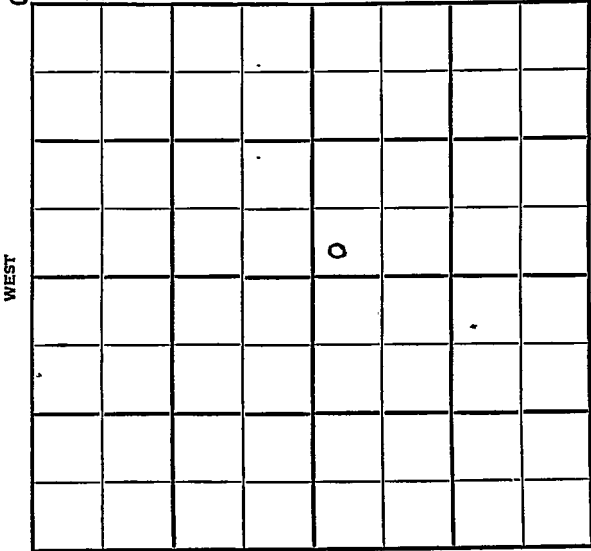

SOUTH

Sec. 1 Twp. 29 R. 40W

Well No. #1 Julian "B" Farm
Stanolind Company


Hugoton

_____ Ft. from N. Line

150 Ft. from S. Line

_____ Ft. from E. Line

150 Ft. from W. Line

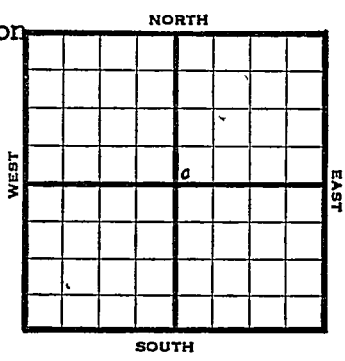

SW NE

1947

Elev. 3241' REPORT.

10/22

8" @ 645' WOC

10/29

Drlg. 3372'

11/12

5" @ 2437'
 Perf.
 11,500 acid
 2,475,000 Gas
 Rock Pressure 405#
 Total Depth 2460'

COMPLETED

Hugoton

Map No. _____ Sec. 1 Twp. 29 R. 4 CW

Well No. 1 Julian "B"

Stanolind

Company

FIRST REPORT

Contractor

SW NE

SECTION PLAT

_____ Ft. from N. Line

150 Ft. from S. Line

_____ Ft. from E. Line

150 Ft. from W. Line

		0	

Stanton County

Location _____

Rig up _____

Drilling and Remarks:

8' @ 645' WOC

RECORD

Cased _____ in., _____ ft.

Sand _____

Gas _____

Oil _____

Total Depth _____

PRODUCTION

1st 24 hrs. Nat. _____

1st 24 hrs. after shot _____

Gas _____ Cu. Ft.

Dry Hole _____

Abandoned _____

Date

OCT 22 1947 19

S. J. LEWIS

Scout

Map No. ✓ Sec. 1 Twp. 29 R. 40WWell No. 1 Julian "B"Stanolind CompanyCOMPLETE Contractor

SW NE

E 10 24 7
SECTION PLAT Ft. from N. Line150 Ft. from S. Line Ft. from E. Line150 Ft. from W. Line

Stanton County

Location Rig up

Drilling and Remarks:

5' 02437Perf
1150000002,475,000 Gas1105 R/A

RECORD

Cased in., ft.Sand Gas Oil Total Depth 2460

PRODUCTION

1st 24 hrs. Nat. 1st 24 hrs. after shot Gas Cu. Ft.Dry Hole Abandoned

Date

NOV 12 1947

19

S. J. LEWIS

Scout