

Kingman

KANSAS

10

29

9W

SECTION

TOWNSHIP

RANGE


WELL NO.

#1 P. Henning

COMPANY

M & L Oil

NORTH

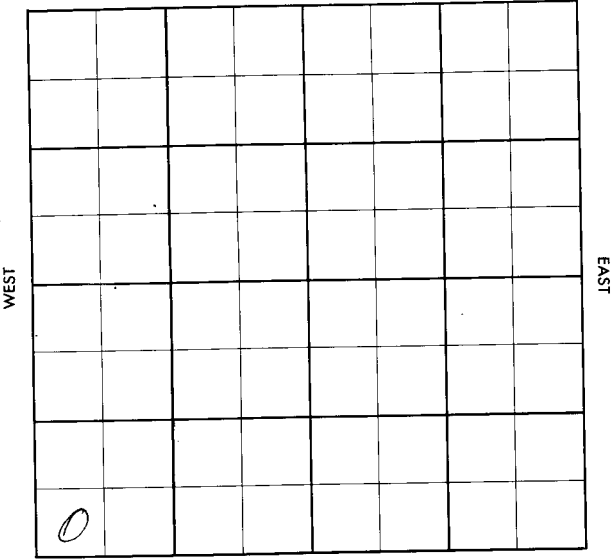

SOUTH

County Kingman Elev. _____
 Sec. 10 Twp. 29 Rge. 9W
 Company M & L Oil
 Farm Name P. Henning No. 1

TOPS	DEPTH	LOG	DATUM	Loc. in Sec.
Anh.				SW SW SW
Tr.				
H.				
Tr.				
Dg.				
Bl.				
L.				Geol. _____
K.C.				Contr. _____
B.K.C.				
Ce.				<u>Anschutz</u>
C.				
M.				Pool _____
M.				<u>Willowdale</u>
K.				
Mz.				
Me.				
V.				
S.				
S.				
A.				
R.				
Pe.				
G.				
ED				

FIRST REPORT
 DEC 12 '56

Date Comm. M I R

27

County Kingman Elev. 1679
 Sec. 10 Twp. 29 Rge. 9W
 Company M & L Oil
 Farm Name P. Henning No. 1

TOPS	DEPTH	LOG	DATUM	Loc. in Sec.
Ant.				SW SW SW
Tr.				
H.	3374			
Tr.	3390			
D.	3403			
B.	3458-71			
L.	3582			
K.C.				Geol.
B.K.C.	4006			Contr.
Ce.				Anschutz
C.				Pool
M.	4207			Willowdale
M.				
K.	4308			
Mz.				
Mo.				
V.	4498			
S.				
S.				
A.				
R.				
Pe.				
G.				
TD.	4502			

ABANDONED

DEC 26 56

0

Date Comm.

M I R DEC 10 56 12-11-56 878

210/125 M. 3450 DEC 26 56

D & A.