


Section 10 Township 29 Range 33W

Well No. #1 Harris

Company National Assoc.

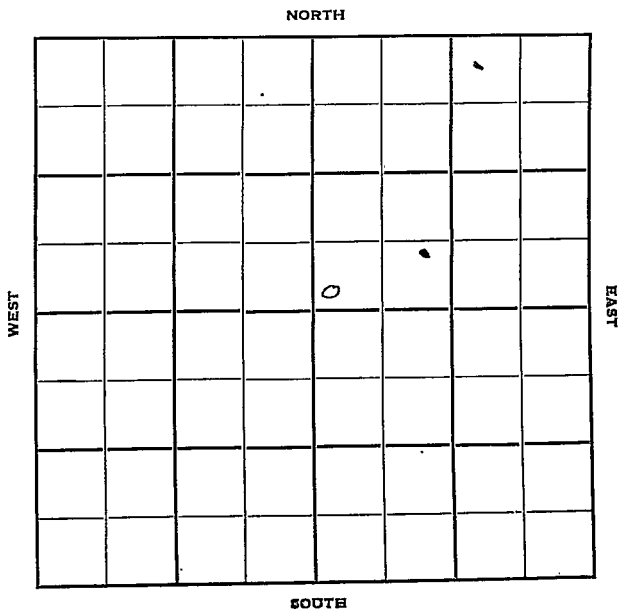


Sec. 10 Twp. 29 R. 33W

Well No. #1 Harris Farm

National Assoc. Company

Hugoton Contractor

_____ Ft. from N. Line
150' _____ Ft. from S. Line
_____ Ft. from E. Line
150' _____ Ft. from W. Line

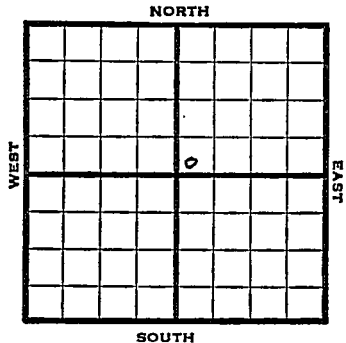

SW SW NE

1951 Elev. 2957' REPORT

10/17 Spud 10-13-51
8" @ 602
Drlg. 1595

1952
2/6 TD 2745 5" @ 2744

2/13 NR

2/20 "

3/5 NR

3/12 "

3/19 No report

3/25 MICT

4/1 TD 2764' PB 2730'

4/9 264/2675-2718 SSG 1000 A Drove plug
to btm 2000 A 8000 A 3000 A 2000 A
4000 A 3000 A, total 23000 A
12,780,000 gas gauge

4/16 Spud 10-13-51 Gas Well TD 2764
8" @ 602 5" @ 2744 TD 2745
Her. 2672 Kri 2704 Win 2746
LD 2764 PB 2730 264/2674-2718
SSG 1000 A DP to TD
23,000 A Comp. 12,780,000 gas

COMPLETED

County **Haskell** State **Kansas**

Sec. **10** (Blk. Twp.) **29** (Sur. Rge.) **33W** Map No.

Operator **National Assoc.**

Well No. **1** Farm **Harrie**

Elev. Location **SW SW NE**

FIRST REPORT					

150 Ft. From **S** Line **NE**

150 Ft. From **W** Line **Quarter**

1st. Report **OCT 170 1951**

Completion

Remarks

Spudding Date **10-13-51**

Drig. Data **Hugoton**

8" @ 602 Drig. 1595

