

Kiowa

KANSAS

11

29

18W

SECTION _____ TOWNSHIP _____ RANGE _____


WELL NO. #1 Klug

COMPANY Rupp-Ferguson

NORTH

WEST

EAST

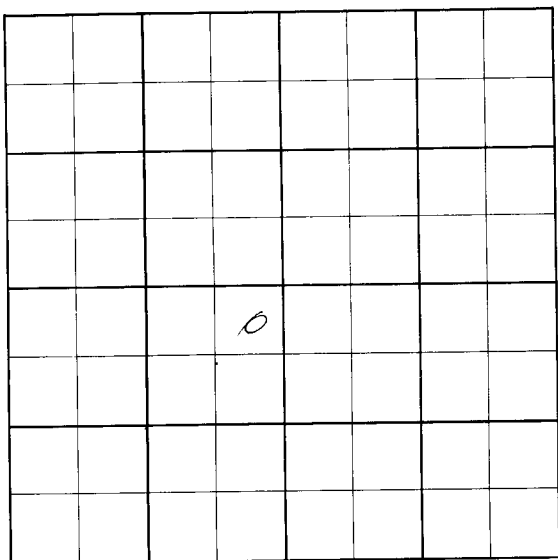

SOUTH

County	Kiowa	Elev.	
Sec.	11	Twp.	29S
Company	Rupp-Ferguson		
Farm Name	Kling	No.	1

TOPS	DEPTH	LOG	DATUM	Loc. in Sec.
Anb.	1180			NE NE SW
Tr.				DS * N1SW1
Dg.				F. Lillibridge
Bl.				Geol.
L.				Contr.
H.C.				Co.
B.K.C.				Pool
Ce.				Ident
C.				FIRST REPORT 1/5 mile OCT 3 '86
M.				
M.				
K.				
Mz.				
Me.				
V.				
S.				
S.				
A.				
R.				
Pe.				
G.				
TD				

Date Comm. **9-24-56**

13" 340, D 3585

2701

215

County KiowaElev. 2267Sec. 11Twp. 29SRge. 18WCompany Ruth - FergusonKlugNo. 1

	DEPTH	LOG	DATUM
1P	1180		
H.	4144	4148	
T.			
D.		4198	
B.	4316	4320	
L.	4336	4334	
K.			
W.	<u>Marm</u>	4753	
C.		4878	
C.			
M.		4950	
M.			
K.			
N.			
M.			
V.			
S.			
S.			
A.			
R.			
P.			
B.			
T.	5017		

Loc. in Sec. _____

NE NE SWDS & ESWF. 1311161130

Geol. _____

Contr. _____

Co. _____

Pool _____

Wildcat1/2 mileOCT 17 '56Date Comm. 9-21-56TIME13" 340; D 3585OCT 10 '56D 4616OCT 17 '56DST 4950-71 1 hr rel 50'50CM FP 0-0 BHP 660/20DST 4971-5000 1 hr rel 120'WM FP 0-0 BHP 1100/20"DCA