


DX 78-1

Section 11 Township 29 Range 9W  
 Well No. 1 Amsden  
 Company Cities Service

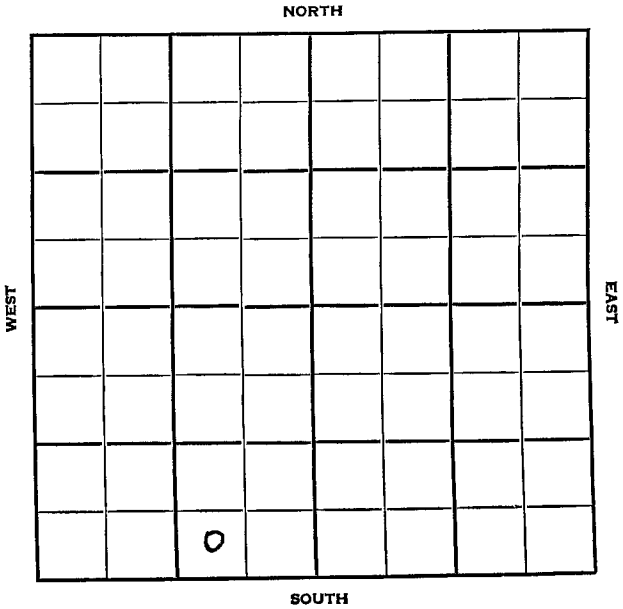

## Kingman KANSAS

|      |      |    |
|------|------|----|
| SEC. | TWP. | R. |
| 11   | 29   | 9W |

WELL NO.

1 Amsden

FARM

COMPANY

Cities Service

CONTRACTOR

Barbour

Willow Dale Pool

Ft. from N. Line

330


Ft. from S. Line

990

Ft. from E. Line

Ft. from W. Line


SW SE SW

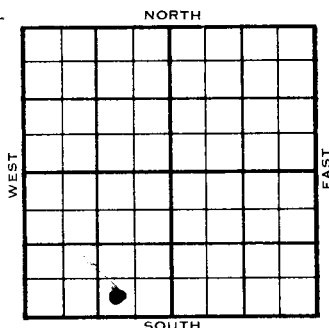

|      | ELEVATION                             | REPORT |
|------|---------------------------------------|--------|
| 1954 | 1685'                                 |        |
| 7/21 | Spdg 7-18-54                          |        |
|      | 8" @ 339                              |        |
|      | Drlg. 720                             |        |
| 9/8  | Spud 7-18-54                          |        |
|      | Oil Well                              |        |
|      | TD 4488'                              |        |
|      | 8" @ 339'                             |        |
|      | Heeb 3327', Dodge 3343', Doug 3359'   |        |
|      | Lans 3542', Miss 4184',               |        |
|      | DST 4185'-94' opn 1 hr, gas in 11 min |        |
|      | rec 55' Mud, 1400# Kh. 4290', Viola   |        |
|      | 4458'                                 |        |
|      | DST 4459'-69' opn 1 hr, gas in 9 min  |        |
|      | rec 1800' oil, 90'mco, 1340#          |        |
|      | DST 4471'-85' opn 1 hr, rec 97' gco   |        |
|      | 124' mco, 1340#                       |        |
|      | TD 4488'                              |        |
|      | 5" @ 4488'                            |        |
|      | CO to 4479'                           |        |
|      | 49/ 4458'-70'                         |        |
|      | FU 1860' oil 2 hr. S/ 60 bo 8½ hr.    |        |
|      | 500 A F/ 125 bo 10 hr. F/ 40 bo 1½ hr |        |
|      | Comp. BHB 1496 bopd. 1520#            |        |

COMPLETED

County Kingman State Kansas  
 Sec. 11 (Blk.) 29 (Sur.) 9W Map No.  
 Operator Cities Service  
 Well No. 1 Farm Amsden  
 Elev. Location SW SE SW

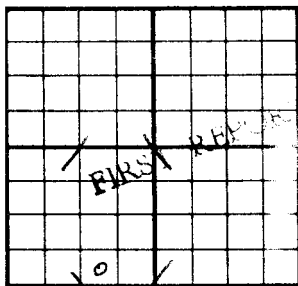

330 Ft. From S Line SW

990 Ft. From E Line Quarter

1st. Report JUL 21 1954

Completion

Remarks

Barbour - Contr.


Spudding Date 7-18-54

Drlg. Data

Willow Dale Pool

8" @ 339 drlg. 720

County Kingman State Kans.  
 Sec. 11 (Blk. 29) (Sur. 9W) Map No.   
 Operator Cities Service  
 Well No. 1 Farm Amsden  
 Elev. 1685 Location SW SE SW

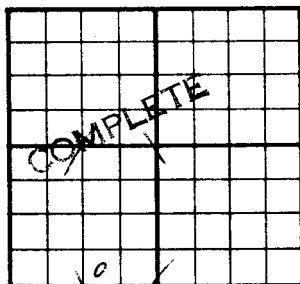

330 Ft. From S Line SW

990 Ft. From E Line Quarter

1st. Report

Completion SEP 8 1954

Remarks Willow Dale Pool  
Barbour - Contr.

Spudding Date 7-18-54

Drlg. Data Oil well TD 4488

8" @ 339 Heeb. 3327 Dodge 3343

Doug. 3359 Lans. 3542 Miss. 4184

DST 4185-94 open 1 hr. gas in 11 min.

Rec. 55' mud 1400# Kh. 4290

Viola 4458 DST 4459-69 open 1 hr.

gas in 9 min. Rec. 1800' oil 90' mco

1340# DST 4471-85 open 1 hr. Rec.

97' gco 124' mco 1340# TD 4488

5" @ 4488 CO to 4479 49/ 4458-70

FU 1860' oil 2 hr. S/ 60 bo 8½ hr.

500/A F/ 125 bo 10 hr. F/ 40 bo 1½ hr.

Comp. BHB 1496 bopd 1520#

FABEN GILSTRAP