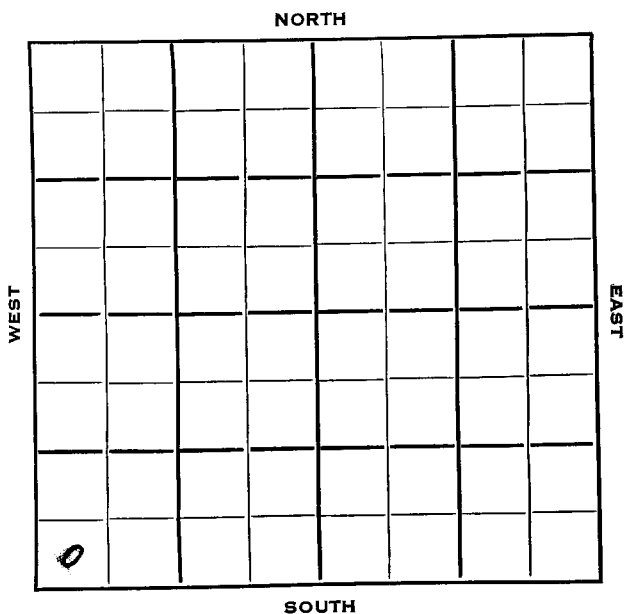


Section 11 Township 29 Range 9WWell No. 1 AmsdenCompany Aurora Gasoline

Kingman

SEC.	TWP.	R.
11	29	9 W ✓

WELL NO. _____

COMPANY # 1 Amsden FARM

CONTRACTOR Aurora Gasoline

Aylward


Wildcat

_____ Ft. from N. Line

330 _____ Ft. from S. Line

_____ Ft. from E. Line

330 _____ Ft. from W. Line

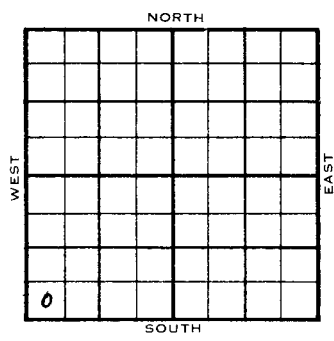

SW SW SW
CSO - Ac. & DHM

	ELEVATION	REPORT
1954	1700	

5/5 Spud 4-30-54
8" @ 132
Drlg. 2550'

5/12 Heeb 3333' Doug 3373'
DST 3364'-87' 1 hr, 30' M 1040#
DST 3409'-46' 1 hr, 960' Wtr. 1130#
B. L. 3556', Lans 3562'

6/23 Drlg 3930'
Spudding 4-30-54
Oil Well
TD 4688
8" @ 132
Heeb 3333 Doug. 3373
DST 3364-87 open 1 hr. Rec. 30' mud 1040#
DST 3409-46 open 1 hr. Rec. 960' wtr. 1130#
Br. lime 3556 lans. 3567 BKC 3995
Miss. 4199
DST 4200-05 open 1 hr. gas in 48 min
Rec. 31' gcm 1220#
DST 4205-10 open 1 hr. Rec. 90' gcm 30' wtr. 810#
Kh. 4316 Meisner 4491 Viola 4502
DST 4502-06 open 1 hr. gas in 22 min.
Rec. 970' oil 1570#

OVER

1954

6/23 DST 4506-11 open 1 hr. Rec. 2580' gas
120' mud & gcm 1450#
Simp. 4550 Simp sd. 4552
DST 4551-56 open 1 hr. Rec. 82' mud &
SW
1650
Arb 4670
TD 4688
5" @ 4688
CO to 4688
20/ 4501-06 FU 150' oil 1 hr.
FU 2500' oil 16 hr. S/ 3 boph 1000 A
S/3 boph F/ 135 21 hr. Comp. 265
bopd 3% wtr.

COMPLETED

County **Kingman** State **Kansas**
 Sec. **11** (Blk.) **29** (Sur.) **9W** Map No.
 (Twp.) (Rge.)

Operator **Aurora Gasoline**

Well No. **1** Farm **Amsden**

Elev. Location **SW SW SW**



330 Ft. From **S** Line **SW**

330 Ft. From **W** Line Quarter

1st. Report **MAY 5 1954**

Completion


Remarks **CSO - AC & DHM**

Aylward - Contr.

Spudding Date **4-30-54**

Drig. Data **Wildcat**

8" @ 132 drlg. 2550

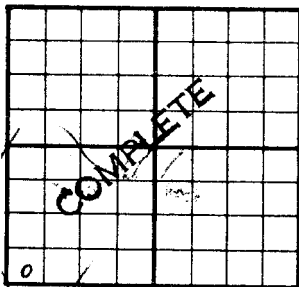County Kingman State KansasSec. 11 (Blk. 28) (Sur. 9W) (Rge.) Map No.Operator Aurora GasolineWell No. 1 Farm AmsdenElev. 1700 Location SW SWSW330 Ft. From S Line SW330 Ft. From N Line Quarter


1st. Report

Completion JUN 23 1954Remarks Willowdale PoolAylward - Contr.Spudding Date 4-30-54Drlg. Data Cil well TD 46888" 132 Heeb. 3333 Doug. 3373DST 3364-87 open 1 hr. Rec. 30' mud1040" DST 3409-46 open 1 hr. Rec.960' wtr. 1130" Sr. line 3556Lans. 3567 B HC 3295 Miss. 4199DST 4200-05 open 1 hr. gas in 40 min,Rec. 31' gcm 1220" DST 4205-10 open1 hr. Rec. 90' gcm 30' wtr. 810"Th. 4316 Reisner 4491 Viola 4502DST 4502-06 open 1 hr. gas in 22 min.Rec. 970' oil 1570" DST 4506-11open 1 hr. Rec. 2560' gas 120' mud &gcm 1450" Simp. 4550 Simp. d. 4552DST 4551-56 open 1 hr. Rec. 82' mud & sw

J. G. McGEHEE

Drig. Data

1650" Arb. 4670 TD 4688 5" 4688
CC to 4688 20/ 4501-06 FU 150' oil
1 hr. FU 2500' oil 16 hr. S/ 3 boph
1000 A S/ 3 boph F/ 135 to 21 hr.
Comp. 265 boph 3" wtr.

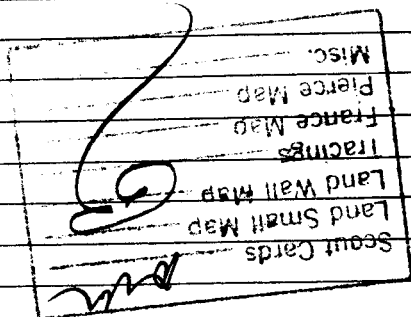

1961