

Kingman

DX 78-1

KANSAS

Section 11 Township 29 Range 9W

Well No. #2 Amsden

Company Cities Service

NORTH

SOUTH

WEST

EAST

0

Kingman KANSAS

SEC.	TWP.	R.
11	29	9W

WELL NO.

2 Amsden

FARM

COMPANY

Cities Service

CONTRACTOR

Barbour

Willow Dale Pool

_____ Ft. from N. Line


990

_____ Ft. from S. Line

330

_____ Ft. from E. Line

_____ Ft. from W. Line

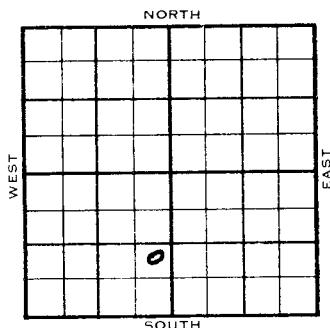

NE SE SW

	ELEVATION	REPORT
1954	1702'	
18/11	Spdg 8-61-54 8" @ 342	
	Drlg. 2040	
9/22	Spud 8-6-54 - Oil Well	
	TD 4509'	
	8" @ 342'	
	Heeb 3346', Dodge 3361', Doug 3376', Lans 3550', Miss 4210'	
	DST 4211-25', opn 1 hr., rec. 30' mud, 180#	
	Kh. 4305', Viola 4480'	
	DST 4481-95', opn 1 hr., gas in 5", rec. 3800' oil, 1320#	
	TD 4509'	
	5" @ 4509'	
	CO to 4495'	
	41/4480-90, gas in 5", rec. 850' oil, 2700' oil, 1½ hrs.,	
	F/60 bo 6 hrs., 250 A	
	F/258 bo 16 hrs.	
	Comp. BHB 3000 bopd	

COMPLETED

County **Kingman** State **Kansas**Sec. **11** (Blk.) **29** (Sur.) **9W** Map No.Operator **Cities Service**Well No. **2** Farm **Amsden**Elev. Location **NE SE SW**

FIRST REPORT

0


990 Ft. From **S** Line **SW**330 Ft. From **E** Line Quarter1st. Report **AUG 11 1954**

Completion

Remarks

Barbour - Contr.Spudding Date **8-6-54**Drlg. Data **Willow Dale Pool****8" @ 342 drlg. 2040**

+

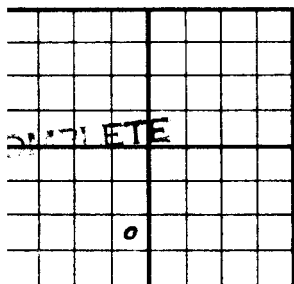County Kingman State KansasSec. 11 (Blk.
Twp.) 29 (Sur.
Rge.) 9W Map No.Operator Cities ServiceWell No. 2 Farm AmsdenElev. 1702 Location NE SE SW

990 Ft. From S Line SW

330 Ft. From E Line Quarter

1st. Report Aug 11 1954Completion SEP 22 1954

Remarks

Barbour - Contr.Spudding Date 8-6-54

Orig. Data Oil well TD 4509 Willow Dale Pool

8" @ 342 Heeb. 3346 Dodge 3361

Doug. 3376 Lans. 3550 Miss. 4210

DST 4211-25 open 1 hr. Rec. 30' mud

180# Kh. 4305 Viola 4480 DST 4481-95

open 1 hr. gas in 5 min. Rec. 3800' oil

1320# TD 4509 5" @ 4509 CO to 4495

41/ 4480-90 gas in 5 min. Rec. 850' oil

2700' oil 1½ hr. F/ 60 bo 6 hr.

250 A F/ 258 bo 16 hr. Comp. BHB 3000

bopd

FAREN OIL STRAP