


DX 78-1

Kingman KANSAS

Section 11 Township 29 Range 9 W

Well No. # 1 Conrady

Company Aylward Drlg.

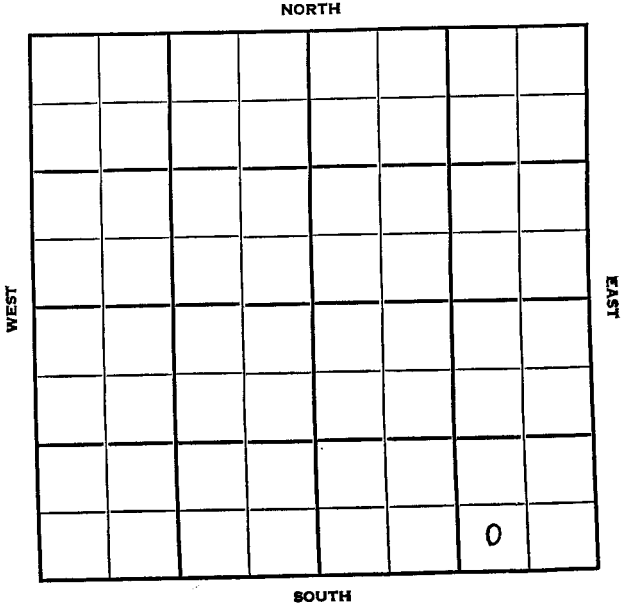


County Kingsman State Kansas

Sec. 11 (Blk. 29) (Sur. 9W) (Twp.) (Rge.) Map No.

Operator Aylward Drlg.

Well No. 1 Farm Conrady

Elev. 1693 Location SW SE SE

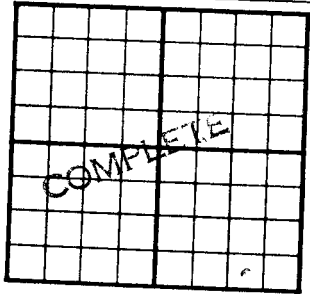

330 Ft. From S Line SE
990 Ft. From E Line Quarter

Ist. Report

Completion FEB 9 1955

Remarks Willowdale Pool

Co. tools

Spudding Date 12-16-54

Drig. Data Oil well TD 4525

8" @ 148 Miss. 4206 DST 4486-93

open 1/2 hr. gas in 4 min. Rec. 3560' oil

1500# TD 4525 Miss. 4209 Viola 4489

5" @ 4525 20/ 4485-90 F/ 10 bo 1 hr.

F/ 30 boph 2 hr. F/ 12 boph 8 hr.

Comp. 406 bopd

FABEN GILSTRA