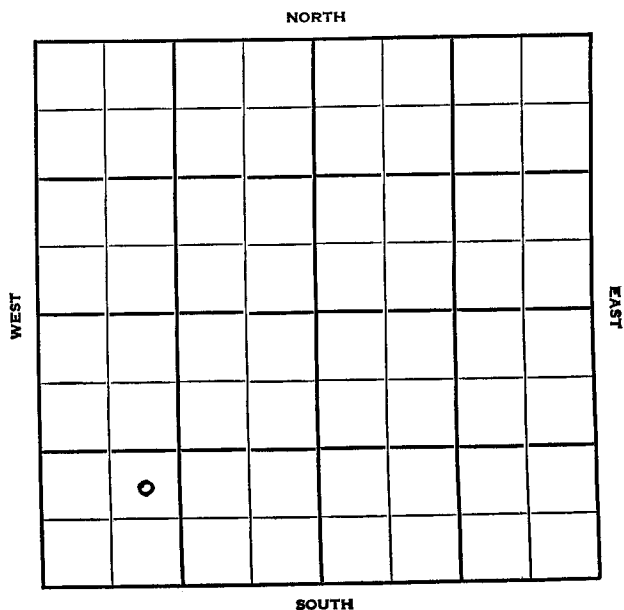


Section 11 Township 29 Range 9WWell No. 2 AmsdenCompany Aylward Drlg. & Aurora

Kingman KANSAS

SEC.	TWP.	R.
11	29	9W

WELL NO.

2 Amsden

FARM

COMPANY

Aylward Drlg. & Aurora

CONTRACTOR

Col Tools


Willowdale Pool

_____ Ft. from N. Line

990 _____ Ft. from S. Line

_____ Ft. from E. Line

990 _____ Ft. from W. Line

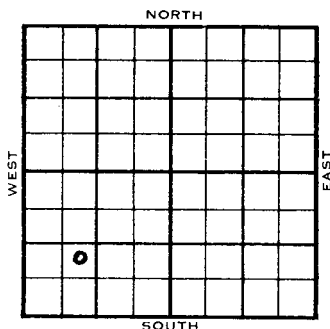

NE SW SW

	ELEVATION	REPORT
1954	1698'	

8/25	Location
11/23	Spud 9-10-54 - OilWell TD 4539' 8-5/8" @ 130' Miss 4210', Viola 4504' DST 4503-10', opn 1 hr., rec. 3300' oil, 1546# TD 4539' 5" @ 4539' CO to 4531' 36/4503-12, FU 400' oil 1/2 hrs. F 75 BO 5 hrs. F 20 boph 1 hrs. Comp. F 105 BOPD 22% wtr. Schl Tops: Heeb 3334', Tor 3354', Doug. 3374', Lans 3560', Miss 4210', Viola 4503'

COMPLETED

Sec. **11** (Blk. Twp.) **29** (Sur. Rge.) **9W** Map No.Well No. **2** Farm **Amsden**

Elev.	Location	NF SW SW
-------	----------	-----------------

FIRST REPORT

990 Ft. From **S** Line **SW**

990 Ft. From W Line Quarter

1st. Report AUG 25 1954

Completion

Remarks

Co. tools

Spudding Date

Orig. Data Willowdale Pool

Location

FABEN GILSTAD

