


Section 11 Township 29 Range 9 W

Well No. # 3 Amsden

Company Cities Service

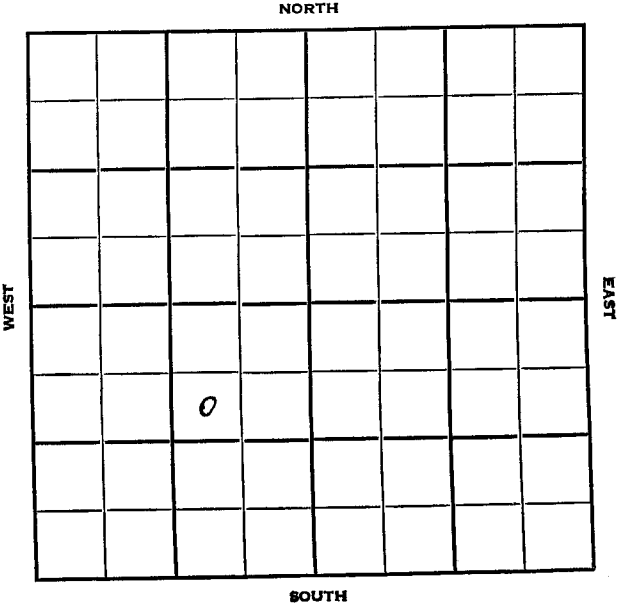

Kingman KANSAS

SEC.	TWP.	R.
11	29	9W

WELL NO.

3 Amsden

FARM

COMPANY

Cities Service

CONTRACTOR

Barbour

Willowdale Pool

990

Ft. from N. Line


Ft. from S. Line

990

Ft. from E. Line

Ft. from W. Line

SW NE SW

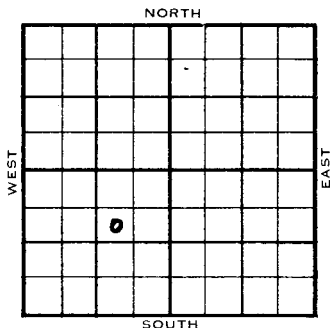

1954

ELEVATION

1699'

REPORT

10/13

Spud 10-7-54

8" @ 304'

Drlg. 2450'

10/27

Spud 10-7-54 D & A TD 4536

8" @ 304' Leeb 3343 Dodge 3361

Lans. 3553 Miss 4208

DST 4209-23, open 1 hr rec 65' mud &

SW 1380# Kh. 4323' Viola 4506'

DST 4507-11, open 1 hr rec 150' OCM

60' SW 1530#

DST 4511-16 open 1 hr rec 900' OGSW

1500' TD 4536' D & A

ABANDONED

County Kingman State Kansas

Sec. **11** (Blk. **29** (Sur. **9W** Map No.

Operator **Cities Service**

Well No. **3** Farm **Amsden**

Elev.	1699	Location	SW NE SW
-------	------	----------	----------

IRST REPORT

990 Ft. From N Line SW

990 Ft. From E Line Quarter

1st. Report OCT 13 1954

Completion

Remarks

Barbour - Contr.

Spudding Date **10-7-54**

Drig. Data Willowdale Pool

8" @ 304 drlg. 2450


County Kingman State Kansas

Sec. 11 (Blk. 29) (Sur. 9W) Map No.

Operator Cities Service

Well No. 3 Farm Amsden

Elev. 1699 Location SW NE SW

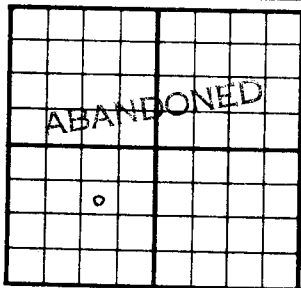

990 Ft. From N Line SW

990 Ft. From E Line Quarter

1st. Report

Completion OCT 27 1954

Remarks Willowdale Pool

Barbour - Contr.

Spudding Date 10-7-54

Drlg. Data D & A TD 4536

8" @ 304 Heeb. 3343 Dodge 3361

Lans. 3553 Miss. 4208 DST 4209-23

open 1 hr. Rec. 65' mud & sw 1380#

Kh. 4323 Viola 4506 DST 4507-11

open 1 hr. Rec. 150' ocm 60' sw 1530#

DST 4511-16 open 1 hr. Rec. 900' ocs w

1500# TD 4536

D & A

FABEN OILSTRAP