


DX 78-1

Kingman KANSAS

Section 11 Township 29 Range 9 W

Well No. # 2 Conrady

Company Aylward Drig.

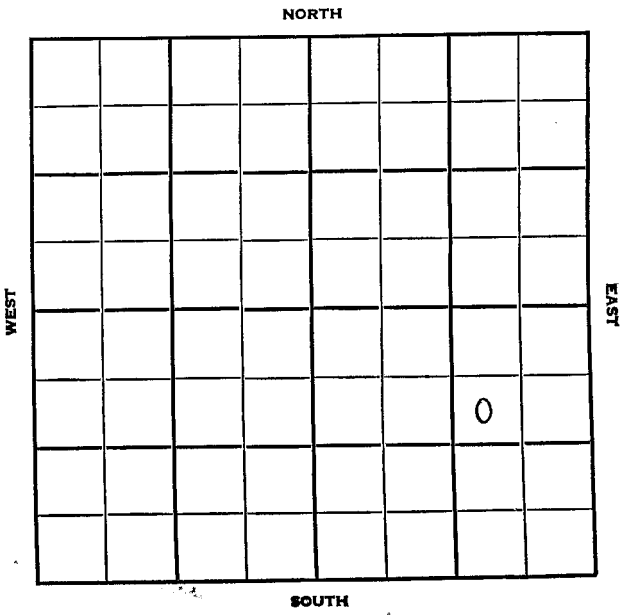

Kingman

KANSAS

SEC.	TWP.	R.
11	29	9W

WELL NO. #2 Conrady FARM

COMPANY

CONTRACTOR Aylward Drlg.

Co. Tools.

990 Willowdale Pool

990

990

SW NE SE

	ELEVATION	REPORT
1954	1703'	
12/29		Spud 12-27-54 Rng. Surface pipe.
1955 2/2		Spud 12-27-54 Oil well TD 4530 8" @ 150 Viola 4495 DST 4496-4501 open 45 min, rec 3180' oil 1485# TD 4530 5" @ 4530 CO to 4505 20/4494-97 S & F/112 BO 2 1/2 hr. F/18 1/2 BOPH 8 hr. Comp. BHB 3000 BOPD
		COMPLETED

