


Sedgwick

FORM 51 5M 1-42 PETROL

Section 11 Township 29 Range 1-W

Well No. 1 Capron

Company Newman Bros.
~~Wm. Bartlett & Continental~~

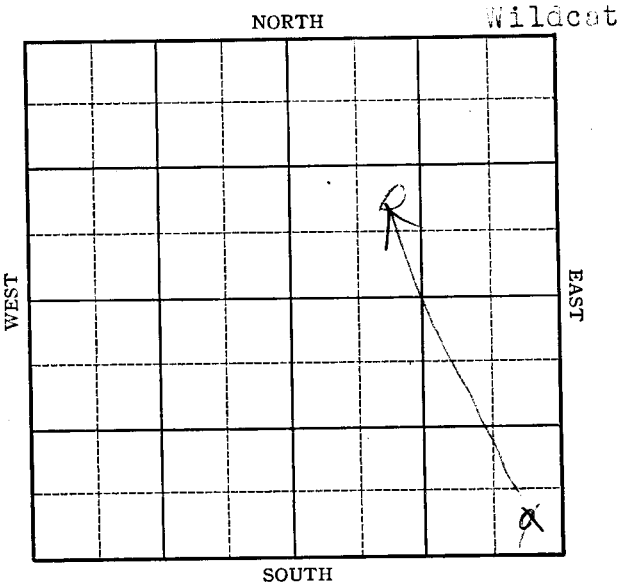

Sedgwick

Sec. 11 Twp. 29 R. 1-W

Well No. #1 Capron Farm
NEWMAN Bros
Wm. Bartlett & Continental Company

(Wildcat)


Ft. from N. Line

330 Ft. from S. Line

330 Ft. from E. Line

Ft. from W. Line

Elev. 1286

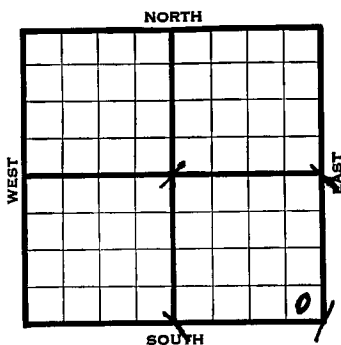


1942	REPORT
3/4	Location
3/12	Berrick.
3/19	Surface hole.
3/26	8" - 252' Drlg. 1322'
4/1	Topeka 1750'
	Lans. 2438'
	Miss. 3289'
	T.D. 3370'
	No shows.
	3370' - 3380'

Map No. 38 Sec. 11 Twp. 29 R. 1WWell No. 1 CapronWm. Bartlett & Contine, Inc. Company**FIRST REPORT**

Contractor

SE/C

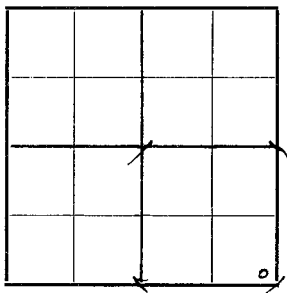SECTION PLAT Ft. from N. Line330 Ft. from S. Line330 Ft. from E. Line Ft. from W. Line**WILDCAT**Location XXRig up Drilling and Remarks: **RECORD**Cased in., ft.Sand Gas Oil Total Depth **PRODUCTION**1st 24 hrs. Nat. 1st 24 hrs. after shot Gas Cu. Ft.Dry Hole Abandoned

Date

MAR 4 1942 19S. J. LEWIS Scout

Sedgwick

KANSAS


Map No. 38 Sec. 11 Twp. 29 R. 1WWell No. 1 CapronWm. Bartlett & Continental Company

ABANDONED

Contractor

SE/C

SECTION PLAT

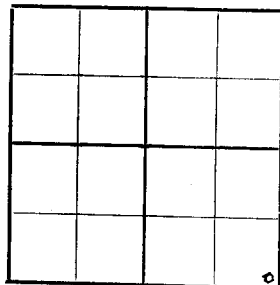

_____ Ft. from N. Line

330 Ft. from S. Line330 Ft. from E. Line

_____ Ft. from W. Line

WILDCAT

Location _____

Rig up _____

Drilling and Remarks:

*Spoke 1750**Lease 2438**Miss 3289**No show*

RECORD

Cased _____ in., _____ ft.

Sand _____

Gas _____

Oil _____

Total Depth 3370

PRODUCTION

1st 24 hrs. Nat. _____

1st 24 hrs. after shot _____

Gas _____ Cu. Ft.

Dry Hole _____

Abandoned _____

Date

APR 1 1942 19

S. J. LEWIS Scout