

Section 11 Township 29 Range 2W


Well No. 1 Chambers

Company Leo Wentworth

Sedgwick County

NORTH

Chambers Pool

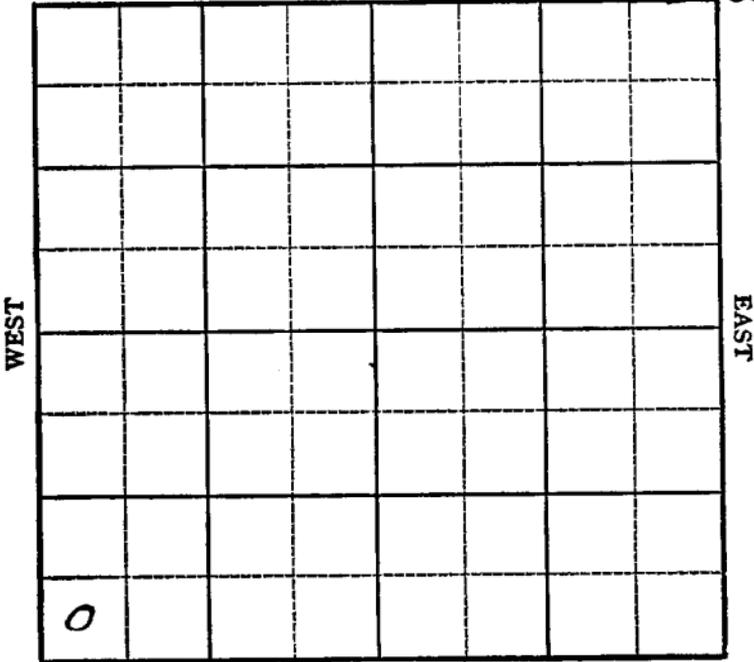

SOUTH

Sec. 11 Twp. 29 R. 2W

Well No. 1 Chambers Farm

Lee Wentworth Company


Chambers Pool

_____ Ft. from N. Line

330 Ft. from S. Line

_____ Ft. from E. Line

330 Ft. from W. Line

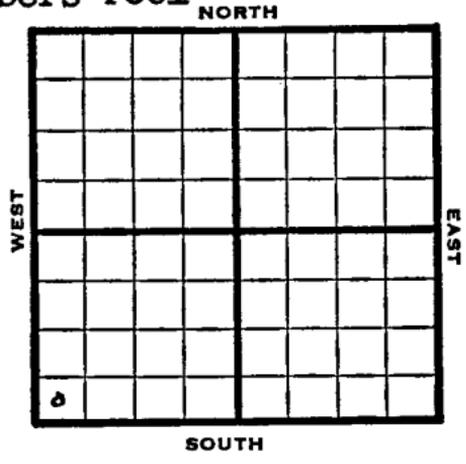

3W/C

| 1948 | Elev 1308' | REPORT |
|-------|-------------------------------|--------|
| 11/17 | Location | |
| 11/23 | " | |
| 11/30 | 90' Run 8" | |
| 12/6 | 8" @ 90' | |
| | Drilg. 2370' | |
| 12/14 | TD 3555' | |
| 12/22 | " | |
| 12/29 | Lansing 2943' | |
| | Miss 3543' | |
| | TD 3626' | |
| | 5" @ 3523' | |
| | 36 shots 3584-3620 | |
| | 1000 acid | |
| 1/5 | " | " |
| 1/12 | " | " |
| 1/19 | " | " |
| 1/26 | " | " |
| 2/2 | " | " |
| 2/9 | Lansing 2943' | |
| | Mississippi 3543' | |
| | TD 3625 | |
| | 5"@ 3623- | |
| | 36 shots 3584-3620 | |
| | 1000 acid | |
| 2/16 | Pump 16 bbls oil & 35 W a day | |

1949

2/23 Pump 16 bbls oil & 35 W aday

3/2 "

3/8 "

3/16 "

3/23 "

3/30 "

4/6 TD 3626'

M¹ss 3543'

5"@ 3623'

Perf 1000 acid

Pump 15 Oil / 35 W Pot

41° Gr.

Comp

COMPLETED

Map No. _____ Sec. 11 Twp. 29 R. 2W

Well No. 1 Chambers

Lee Wentworth Company

FIRST REPORT

Contractor

SW/C

SECTION PLAT

| | | | |
|--|--|--|--|
| | | | |
| | | | |
| | | | |
| | | | |
| | | | |

_____ Ft. from N. Line

330 Ft. from S. Line

_____ Ft. from E. Line

330 Ft. from W. Line

Sedgwick County

Location X

Rig up _____

Drilling and Remarks:

RECORD

Cased _____ in., _____ ft.

Sand _____

Gas _____

Oil _____

Total Depth _____

PRODUCTION

1st 24 hrs. Nat. _____

1st 24 hrs. after shot _____

Gas _____ Cu. Ft.

Dry Hole _____

Abandoned _____

Date

NOV 17 1948 19

S. J. LEWIS Scout

Map No. _____ Sec. 11 Twp. 29 R. ZW

Well No. 1 Chambers

Leo Wentworth Company

COMPLETE

Contractor

SW/C

E 1, 1308
SECTION PLAT

| | | | |
|--|--|--|--|
| | | | |
| | | | |
| | | | |
| | | | |
| | | | |

_____ Ft. from N. Line

330 Ft. from S. Line

_____ Ft. from E. Line

330 Ft. from W. Line

Sedgwick County

Location _____

Rig up _____

Drilling and Remarks:

Miss 3543
5" @ 3623
Prof. 1300 acid
Imp. 15 oil + 35 W.D.
AH-9

RECORD

Cased _____ in., _____ ft.

Sand _____

Gas _____

Oil _____

Total Depth 3626

PRODUCTION

1st 24 hrs. Nat. _____

1st 24 hrs. after shot _____

Gas _____ Cu. Ft.

Dry Hole _____

Abandoned _____

Date

APR 6 1949

19

S. J. LEWIS

Scout