


Section 11 Township 29 Range 2-W

Well No. #1 Chambers "B"

Company Claude Wentworth  
Miscellaneous

NORTH

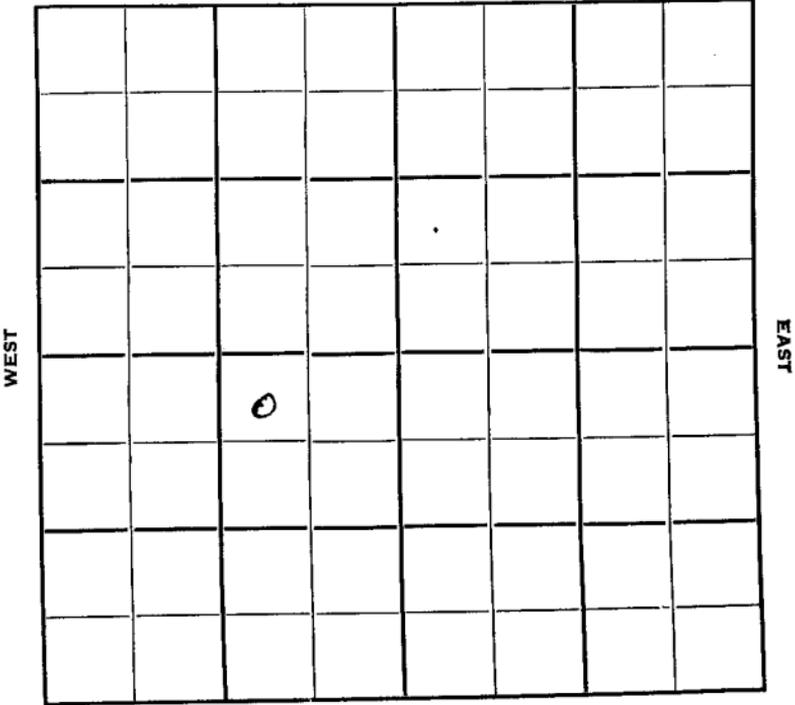

SOUTH

NSAS ✓

Sec. 11 Twp. 29 R. Sedgwick 2W

Well No. #1 Cambers "B" Farm  
Claude Wentworth Company

Miscellaneous


330' Ft. from N. Line

\_\_\_\_\_ Ft. from S. Line

990' Ft. from E. Line

\_\_\_\_\_ Ft. from W. Line

NW NE SW

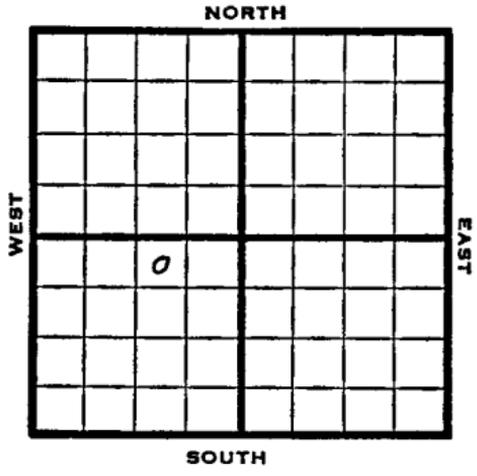

194 REPORT

2/14  
2/21

Location  
TD 3638'  
Miss 3598'  
Aband.

ABANDONED

Map No. \_\_\_\_\_ Sec. 11 Twp. 29 R. 2 W

Well No. 1 Cambers "B"

Claude Wentworth Company

Contractor

NW NE SW

**FIRST REPORT  
SECTION PLAT**

330 Ft. from N. Line

\_\_\_\_\_ Ft. from S. Line

990 Ft. from E. Line

\_\_\_\_\_ Ft. from W. Line

	o		

Sedgwick County

Location X

Rig up \_\_\_\_\_

Drilling and Remarks:

**RECORD**

Cased \_\_\_\_\_ in., \_\_\_\_\_ ft.

Sand \_\_\_\_\_

Gas \_\_\_\_\_

Oil \_\_\_\_\_

Total Depth \_\_\_\_\_

**PRODUCTION**

1st 24 hrs. Nat. \_\_\_\_\_

1st 24 hrs. after shot \_\_\_\_\_

Gas \_\_\_\_\_ Cu. Ft.

Dry Hole \_\_\_\_\_

Abandoned \_\_\_\_\_

Date

DEC 14 1949

19

Scout

Map No. \_\_\_\_\_ Sec. 11 Twp. 29 R. 2W

Well No. 1 Chambers "B"

Claude Wentworth Company

**ABANDONED** Contractor

NW NE SW

**SECTION PLAT**

330 Ft. from N. Line

\_\_\_\_\_ Ft. from S. Line

990 Ft. from E. Line

\_\_\_\_\_ Ft. from W. Line

	o		

Sedgwick County

**RECORD**

Location \_\_\_\_\_

Cased \_\_\_\_\_ in., \_\_\_\_\_ ft.

Rig up \_\_\_\_\_

Sand \_\_\_\_\_

Drilling and Remarks:

Gas \_\_\_\_\_

Oil \_\_\_\_\_

Total Depth 2628

*Min 3598*

**PRODUCTION**

1st 24 hrs. Nat. \_\_\_\_\_

1st 24 hrs. after shot \_\_\_\_\_

Gas \_\_\_\_\_ Cu. Ft.

Dry Hole \_\_\_\_\_

Abandoned \_\_\_\_\_

Date

DEC 21 1949 19

S. J. LEWIS Scout