


Section 11 Township 29 Range 38 W

Well No. # 1 Hickok "B"

Company Western Natural Gas

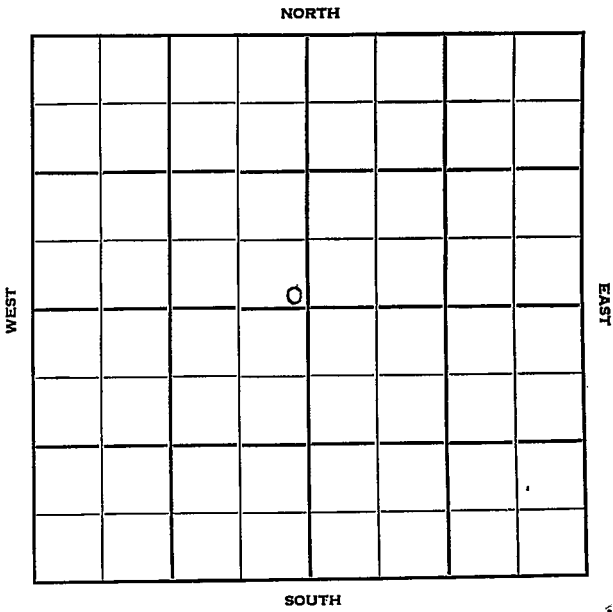

Grant

KANSAS

Sec. 11 Twp. 29 R. 38 W ✓

Well No. # 1 Hickok 11B¹¹ Farm

Western Natural Gas Company

Contractor

Hugoton Pool


Ft. from N. Line

190 Ft. from S. Line

130 Ft. from E. Line

Ft. from W. Line

SE NW

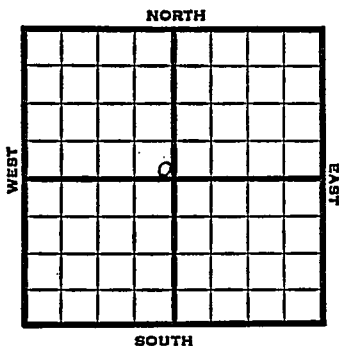

1951 Elv. 3102' REPORT

4/18 Spud 4-12-51
10" @ 623
Drig. 1665'

5/16 Spud 4-12-51
Gas Well TD 2591
10" @ 623
7" @ 2355
TD 2591
Her. 2375 Win. 2440
Ft. Riley 2512
17,000 A Comp. 19,000,000 gas

COMPLETED

County Grant State Kansas

Sec. 11 (Blk. Twp.) 29 (Sur. Rge.) 38W Map No.

Operator Western Natural Gas

Well No. 1 Farm Hickok "B"

Elev. _____ Location SE NW

190 Ft. From S Line NW

130 Ft. From E Line Quarter

Ist. Report APR 18 1951

Completion

Remarks

Spudding Date 4-12-51

Drlg. Data Hugoton Pool

10" @ 623 drlg. 1665

