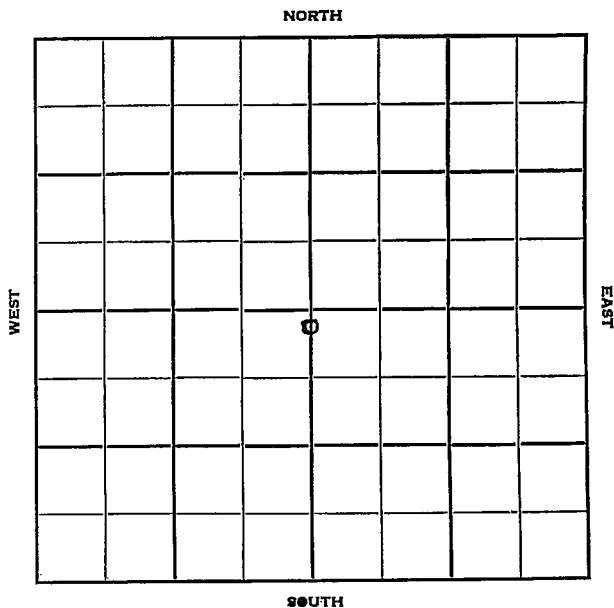


Section 11 Township 29 Range 33WWell No. #1 BrockCompany National Assoc.

Haskell

KANSAS

Sec. 11 Twp. 29 R. 33W

Well No. #1 Brock Farm

National Assoc. Company

Hugoton Contractor


150' Ft. from N. Line

 Ft. from S. Line

 Ft. from E. Line

2340' Ft. from W. Line

N/2 N/2 S/2

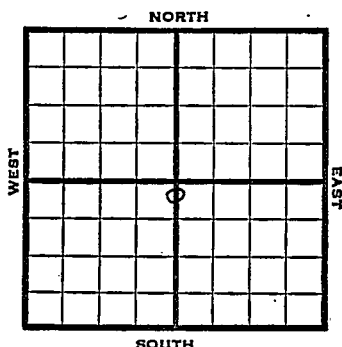

1951 Elev. 2940' REPORT

11/14 Drlg.

1952

2/6 TD 3736 5" @ 2734

2/13 NR

2/20 "

3/5 RUST

3/12 TD 2757 PB 2720 13,000 A

3/19 No report

4/2 Gas Well TD 2757

8" @ 635

Her. 2664

Kri. 2696


Win. 2734

TD 2736 5" @ 2734

DD 2757 PB 2720 13000 A

Comp. 8,064,000 gas

COMPLETED

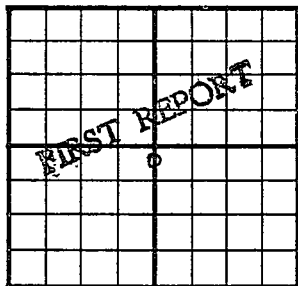County Haskell State KansasSec. 11 (Blk.) 29 (Sur.) 33W Map No.Operator National Assoc.Well No. 1 Farm BrookElev. Location N/2 N/2 S/2150 Ft. From N Line S/2 Sec2640 Ft. From W Line Quarter1st. Report NOV 14 1951

Completion

Remarks

Spudding Date

Drlg. Data Hugoton

Drlg.


J. E. TYRA

County Haskell State Kansas
 Sec. 11 (Blk. Twp.) 29 (Sur. Rge.) 33W Map No.

Operator National Assoc.

Well No. 1 Farm Brock

Elev. 2940 Location N/2 N/2 S/2

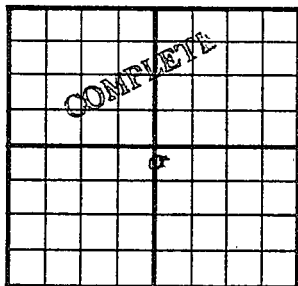

150 Ft. From N Line S/2 sec

2640 Ft. From W Line Quarter

1st. Report

Completion APR 2 1952

Remarks

Spudding Date

Drilg. Data Gas well TD 2757

8" @ 635 Her. 2664 Kri. 2696

Win. 2734 TD 2736 5" @ 2734

DD 2757 PB 2720 13000 A

Comp. 8,064,000 gas

J. G. McGEHEE