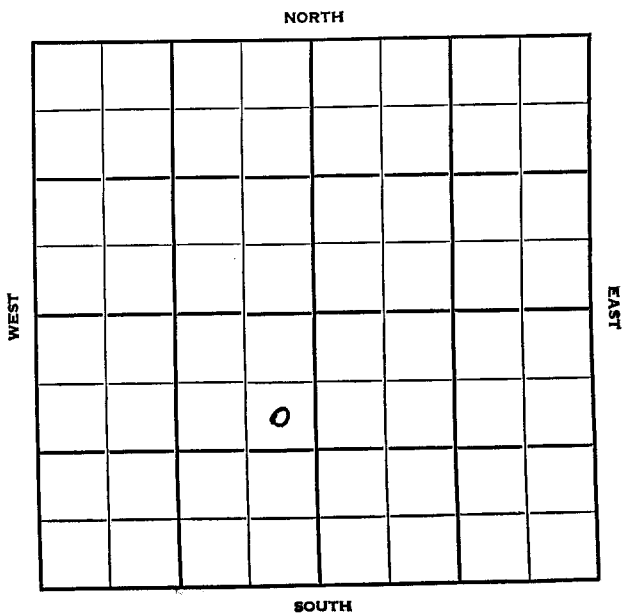


Section 12 Township 29 Range 14WWell No. 1 Moffat "A"Company Lario & Sinclair

Pratt

N 1/4 S 45

SEC.	TWP.	R.
12	29	14 W ✓

WELL NO.

1 Moffat "A"

FARM

COMPANY

Lario & Sinclair

CONTRACTOR

Buick

N. Coats Pool

990

Ft. from N. Line


Ft. from S. Line

330

Ft. from E. Line

Ft. from W. Line

SE NE SW

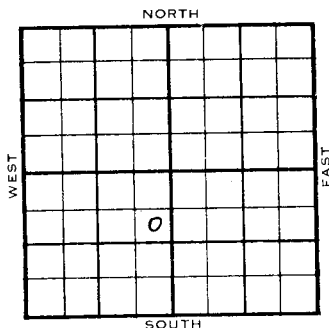

1954

ELEVATION

1989'

REPORT

4/27

RUR

5/5

8" @ 350' w/300 sks

Drlg 2455'

5/12

Top 3201', Heeb 3804', Tor 3820'

Doug 3860'

Drlg 3993'

7/21

Spud 4-28-54

Oil Well

TD 4685'

8" @ 350'

Top 3201', Heeb 3804', Tor 3820',

Doug 3860', Br line 3987', Lans 3995'

DST 4000-30', opn 1 hr., gas in 8",

100,000 cfg, rec. 50' hocm, & muddy

oil, 40' free oil, 1250#

Marm. 4347'

DST 4340-60', opn 1 hr., gas in 12",

213,000 cfg

F/oil in 40"

F/5bo 15"

DST 4412-60', opn 1 hr., rec. 45' mud

790#

Viola 4500'

DST 4518-65', opn 1/2 hrs., rec. 720'

gas, 150' gcm, 150' sw, 1300#

(Information Brought Forward)

1954
7/21

Simp. 4576'

DST 4573-84', opn $1\frac{1}{2}$ hrs., rec. 4520'
gas, 90' vho & gcm, 300' wtr.

DST 4589-99', opn 40", rec. 30' mud,
700#

DST 4579-4607', opn 1 hr., rec. 615'
sw, 150#

TD 4685'

5" @ 4630'

36/4569-75

S/4 goph 1000A

S/75 bf 11 hrs.

S/3 $\frac{1}{2}$ bfph 29% oil
frac

S/8 bo 4 bwph 4 hrs.


60/4342-52, S/7 $\frac{1}{2}$ boph

F/64 boph 2 hrs.

F/10 boph

C omp. 3000 bopd

COMPLETED

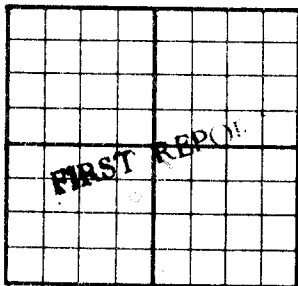County **Pratt** State **Kansas**Sec. **12** (Blk.) **29** (Sur.) **14W** Map No.Operator **Lario & Sinclair**Well No. **1** Farm **Moffat "A"**Elev. Location **SE NE SW**990 Ft. From **N** Line **SW**330 Ft. From **E** Line Quarter1st. Report **APR 27 1954**

Completion

Remarks

Buick - Contr.


Spudding Date

N. Coats Pool

Drlg. Data

P U R**J. G. McGEHEE**

County Pratt State Kansas
 Sec. 12 (Blk. 29) (Sur. 14W) (Twp.) (Rge.) Map No.
 Operator Lario & Sinclair
 Well No. 1 Farm Moffat "A"
 Elev. 1989 Location SE NE SW

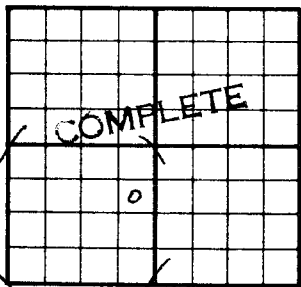

Drlg. Data

Oil well

990 Ft. From N Line SW

330 Ft. From E Line Quarte

1st. Report

Completion JUL 21 1954Remarks N. Coats PoolBuick - Contr.Spudding Date 4-28-54

TD 4685

8" @ 350 Top. 3201 Heeb. 3804

Tor. 3820 Doug. 3860 Br. lime 3987

Lans. 3995 DST 4000-30 open 1 hr.

gas in 8 min. 100,000 cfg Rec. 50' hocr

& muddy oil 40' free oil 1250#

Marm. 4347 DST 4340-60 open 1 hr.

Gas in 12 min. 213,000 cfg F/ oil in

40 min. F/ 5 bo 15 min. DST 4412-60

open 1 hr. Rec. 45' mud 790#

Viola 4500 DST 4518-65 open $\frac{1}{2}$ hr.

rec. 720' gas 150' gcm 150' sw

1300# Simp. 4576 DST 4573-84

open $1\frac{1}{2}$ hr. Rec. 4520' gas 90' who &

gcm 300' wtr. DST 4589-99 open 40 mir

J. G. McGEHEE

Drlg. Data

Rec. 30' mud 700# DST 4579-4607

open 1 hr. Rec. 615' sw 150#

TD 4685 5" 4630 36' 4569-75

S/ 4 goph 1000 A S/ 75 bf 11 hr.

S/ $3\frac{1}{2}$ bfph 29% oil frac S/ 8 bo

4 bwph 4 hr. 60/ 4342-52 S/ $7\frac{1}{2}$ boph

F/ 64 boph 2 hr. F/ 10 boph

Comp. 3000 bopd

1961 22 700