


DX 78-1 Kingman

KANSAS

Section 12 Township 29 Range 9W

Well No. #1 Rohlman

Company Rocket Drlg.

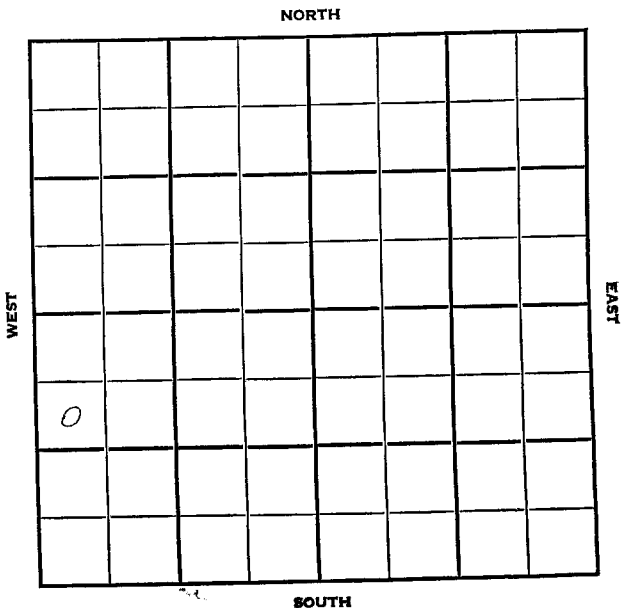


SEC. 12	TWP. 29	R. 9W
------------	------------	----------

WELL NO. #1 Rohlman FARM

COMPANY Rocket Drlg.

CONTRACTOR Co. Tools

_____ FT. FROM N. LINE
 _____ FT. FROM S. LINE
 _____ FT. FROM E. LINE
 _____ FT. FROM W. LINE

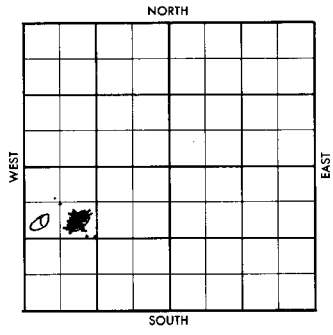

SW NW SW

1956	ELEVATION	REPORT
------	-----------	--------

8-8
 Comm. 8-4-56
 8" @ 180 w/150
 Drlg. 1031

Co.

County **Kingman** Elev. _____
 Sec. **12** Twp. **29** Rge. **9W**
 Company **Socket Drlg.**
 Farm Name **Lohman** No. **1**

TOPS	DEPTH	LOG	DATUM
Anh.			
Tr.			
H.			
Tr.			
Dg.			
Bl.			
L.			
K.C.			
B.K.C.			
Ce.			
C.			
M.			
M.			
K.			
Mz.			
Ma.			
V.			
S.			
S.			
A.			
R.			
Pe.			
G.			
TD			

Loc. in Sec. **SW NW SW**
 Geol. _____
 Contr. _____
Co. tools
 Pool _____

Log.

FIRST REPORT		

Sta.

Date Comm. **8-4-56**
8" @ 180/150 drlg. 1031

AUG 8 '56

[Handwritten signature]

820-1-1000

County Kirgman Elev. 1705
 Sec. 12 Twp. 29 Rge. 9W
 Company Rocket Drlg.
 Farm Name Rohlman No. 1

TOPS	DEPTH	LOG	DATUM	Loc. in Sec.
Ann				SW NW SW
Sp <u>DAKSD</u>	<u>3385</u>			
H.				
Tr.				
Dg.				
Bl.	<u>3564</u>			
L.	<u>3575</u>			
K.C.				Geol. _____
B.K.C.				Conts _____
Ce.				
C.				<u>Co. tools</u>
M.	<u>4216</u>			
M.				Pool _____
K.	<u>4336</u>			
Mz.				
Mo.				
V.	<u>4508</u>			COMPLETE
S.	<u>4549</u>			
A.				
R.				
PE.				
G.				
TA	<u>4586</u>			OCT 17 '56

Date Comm. 8-11-56
8" @ 180/150 drlg. 1031 AUG 15 '56
Ø 4002 AUG 22 '56 DST 4122-4222
op. 30" rec 60' Md BHP 0
DST 4510-13 op 1 hr 4100' 610
rec 110' HO&GCM +100' 9554
clean oil 1290/20" DST 4513
-18 75" 90' Md BHP 1155/20"
5/2 @ 4585/150 AUG 29 '56 CO 12/4508
-11 FU 150' oil 12 hr. 1/20" 8

21 Bo 10 12 hrs \$ 23 1/2 Bo
12 hrs Pop SEP 5 '56 SEP 12 '56 P.

52 Bo 24 hrs w/o POT

SEP 19 '56

SEP 26 '56

OCT 3 '56

OCT 10 '56

OCT 17 '56

Ph P. 166 Bopd 590 wt

DATE