


FORM 51 O.W.W.O. Kingman KANSAS
Section 12 Township 29 Range 9 W
Well No. # 1 Tiesmeyer
Company ~~Stearns Pet.~~ Tenn. Gas Trans.

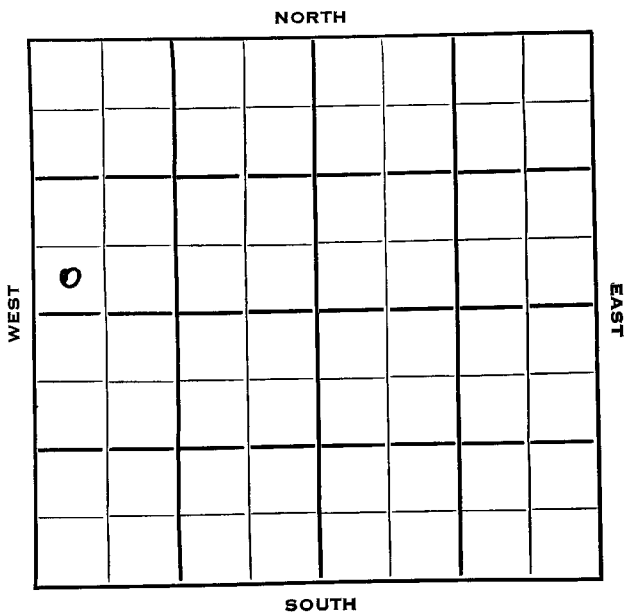

Kingman		KANSAS	
SEC.	TWP.	R.	
12	29	9 W	✓
WELL NO.			
# 1 Tiesmeyer			FARM
COMPANY			
Stearns Pet.			
CONTRACTOR			


Wildcat

_____ Ft. from N. Line

330 _____ Ft. from S. Line

_____ Ft. from E. Line

330 _____ Ft. from W. Line

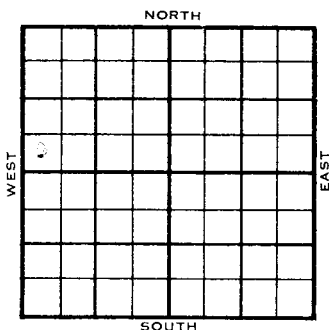

SW SW NW
Magnolia F/O and DHM

	ELEVATION	REPORT
1953	1710'	
11/18	RUR	
1954 1/13	Spud 11-19-53 D&A TD 4696' 8" @ 254' Br lime 3567', KC 3581' DST 3931-46', opn 1 hr., rec. 56' muddy sw, 1620# DST 3964-76', opn 1 hr., rec. 140' muddy sw, 1200# B KC 4020', Miss 4209' DST 4213-25', opn 1 hr., rec. 200' ocm, 1395# Kh 4317' DST 4485-4520', opn 1 hr., rec. 75' socm, 150# Viola 4517', Simp. 4584', Simp sd 4596' DST 4589-4601', opn 1/4 hrs., rec. 2640 sw, 1645# Arb. 4676' TD 4696' 5" @ 4465 CO to 4480 24/4208-18, 500 mud acid S/10 bfph PB 4200	

(Information Brought Forward)

1954

1/13

9/4164-67 dry

11/3963-67 sw

PB 3950

24/3925-30, 10 gfph

perf 3925-32

S/4 gwph

mud-acid

S/41 gwph dec. to 4 gwph 500A

250A

CO to 3940

19/3925-31, 1000A

S/22 bwph SS0 7 hrs.

FU 1700' wtr.

D&A

ABANDONED

County Kingman State Kansas

Sec. **12** (Blk. Twp.) **29** (Sur. Rge.) **9W** Map No.

Operator Stearns Pet.

Well No. 1 Farm Tiesmeyer

Elev.	Location	SW	SW	NW

0

FIRST REPORT

330 Ft. From S Line NW

330 Ft. From W Line Quarter

1st. Report NOV 18 1953

Completion _____

Remarks Magnolia farmout &
DHM

Spudding Date _____


Drig. Data Wildcat

R U R

Wildcat

J. G. McGEHEE

County Kingman State Kansas
 Sec. 12 (Blk. 29 (Sur. 9W Map No.
 (Twp.) (Rge.)
 Operator Stearns Pet.
 Well No. 1 Farm Tiesmeyer
 Elev. 1710 Location S¹ S¹ W¹

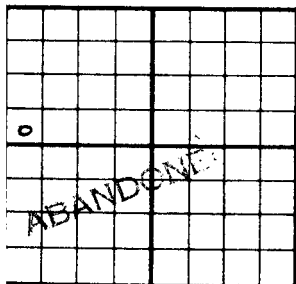

330 Ft. From S Line NE
330 Ft. From W Line Quarter

1st. Report

Completion JAN 13 1954

Remarks Wildcat

Spudding Date 11-19-53

Orig. Data D & A TD 4696

8" C 254 Pr. lime 3567 KC 3581

DST 3931-46 open 1 hr. Rec. 56' muddy

sw 1620" DST 3964-76 open 1 hr.

Rec. 140' muddy sw 1200" B KC 4020

Kiss. 4209 DST 4213-25 open 1 hr.

Rec. 200' ocm 1395" Kh. 4317

DST 4485-4520 open 1 hr. Rec. 75' socm

150" Viola 4517 Simp. 4534 Simp. sd.

4596 DST 4582-4601 open 1 hr. Rec.

2640' sw 1645" Arb. 4676 TD 4696

5" C 4465 CO to 4480 24/ 4208-18

500 mud acid S/ 10 bfph PE 4200

9/ 4164-67 dry 11/ 3963-67 sw

PB 3950 24/ 3925-30 10 gfph

J. G. McGEHEE

O.W.W.O.

County **Kinman**

Elev.

Sec. **12**Twp. **29**Rge. **9W**Company **Tenn. Gas Trans.**Farm Name **Ida B. Tiesmeyer**No. **1**

TOPS	DEPTH	LOG	DATUM
Anh			
Tp.			
H.			
Tr.			
Dg.			
Bl.			
L.			
K.C.			
B.K.C.			
Ce.			
C.			
M.			
M.			
K.			
Mz.			
Me.			
V.			
S.			
S.			
A.			
R.			
Pe.			
G.			
Ed.			

Loc. in Sec.

SW SW NW
(OWWO)

Geol.

Contr.

Pool

FIRST REPORT

0

MAY 1 '37

Date Comm.

Location

27



[illegible]

County KingmanElev. 1710Sec. 12Twp. 29Rge. 9WCompany Tenn. Gas Trans.Farm Name Ida B. TiesmeyerNo. 1

TOPS	DEPTH	LOG	DATUM	Loc. in Sec.
Anh.				SW SW NW TW 17
Tr.				
H.				
Dg.				
BL				Geol.
L.				
K.C.				
B.K.C.				
Ce.				Contr.
C.				
M.	4214			
M.				
K.				Pool
Mz.				
Mo.				
V.	4519			
S.				JUN 19 57 0 ABANDONED
S.				
A.				
R.				
Pe.				ABANDONED
G.				
TD	4523			

Date Comm.

Location 4-29-578 5/8 250/200 D 3523 MAY 19 57DST 4215-22 2 hrs G/L90 108 MCF/90" sec 10' H08' 2 CM + 90' VH 0 8' 2 CM 1415120" DST 4520-23 1 hr30' 0 8' 2 CM + 30' H0 CM BHP600/20" D 2 hrs MAY 22 57 5 1/24520 WOCT MAY 29 57 CO 4523

A channelled & led &
 1 1/4 BFph 90% wt PKC
 4492 S&d O.H. CO 4523
 GRNL. JUN 5 57 A \$ 7 BWph
 15 hrs 3000' O.B. PB
 4280 36/4214-20 200
 Acid & 2 1/2 BWph + Tr.
 oil 24 hrs S&d 4214-20
 CO 4280 PF 20/4214 1/2-19 1/2
 JUN 10 57 21/4222-32 Lost
 T69 in hole S&d All
 P15 CO 4280 RePF 4214 1/2
 -18 1/2 & 10 GSwph + scum
 oil 6 hrs 170 BSW
 in 3 hrs 1500' O.B. JUN 10 57

H J A