

Sedgwick


KANSAS

SECTION 12 TOWNSHIP 29 RANGE 1W

WELL NO. #1 Curless

COMPANY Beardmore Drlg.

NORTH

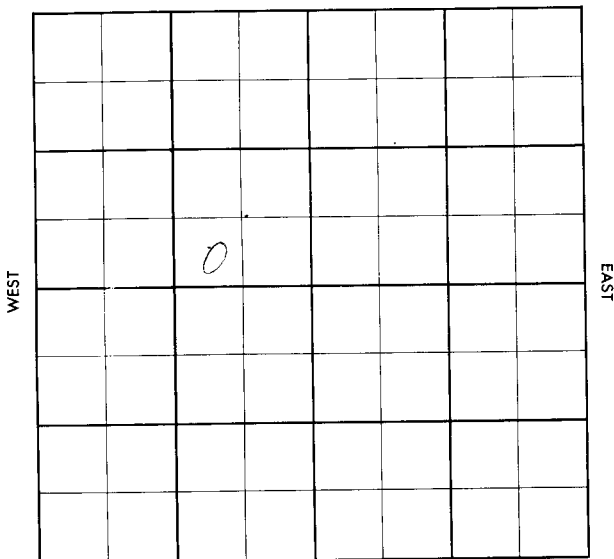

SOUTH

County Sedgwick Elev. _____ Co.
 Sec. 12 Twp. 29 Rge. IW
 Company Beardmore Drilg.
 Farm Name Curless No. 1

TOPS	DEPTH	LOG	DATUM	Loc. in Sec.
Anh.				SW SE NW
Tr.				
H.				
Tr.				
Dg.				
Bl.				
L.				Geol. _____
K.C.				Contr. _____
B.K.C.				Renfro
Ce.				Pool _____
C.				NW Brunley
M.				
M.				
K.				
Mz.				
Ma.				
V.				
S.				
S.				
A.				
R.				
Pe.				
G.				
TD				

FIRST REPORT

JAN 16 '57

Date Comm.

MIR

28

County Sedgwick Elev. 129
 Sec. 12 Twp. 29 Rge. 1W
 Company Beardmore Drllr.
 Farm Name Curless No. 1

TOPS	DEPTH	LOG	DATUM	Loc. in Sec.
Ank.				SW 1/4
Tr.				
H.				
Tr.				
Dg.				Geol.
Bl.				
L.				
K.C.	2743			
B.K.C.				Confr.
Ce.				
C.				
M.	3269			
M.				Pool
K.				
Mz.				
Me.				
V.				NW Brunley
S.				
S.				
A.				
R.				ABANDONED
PE.				
G.				
TD.	3350			

Date Comm.

M I R JAN 23 '57 - 1-15-57 8578
 155/125 M 3140 JAN 26 '57 CRD
 3286-3306 rec. 20' CRD DPT
 3274-86 1hr 2010' GIP rec
 35' HOLE 6 CM + 40' 8 CM & SW FP
 50-75 BHP 600/20" CRD 3306-26
 rec. 20'

D E A