


Sedgwick

KANSAS

SECTION 12 TOWNSHIP 29 RANGE 1W

WELL NO. #1 Rex

COMPANY Geo. R. Vye

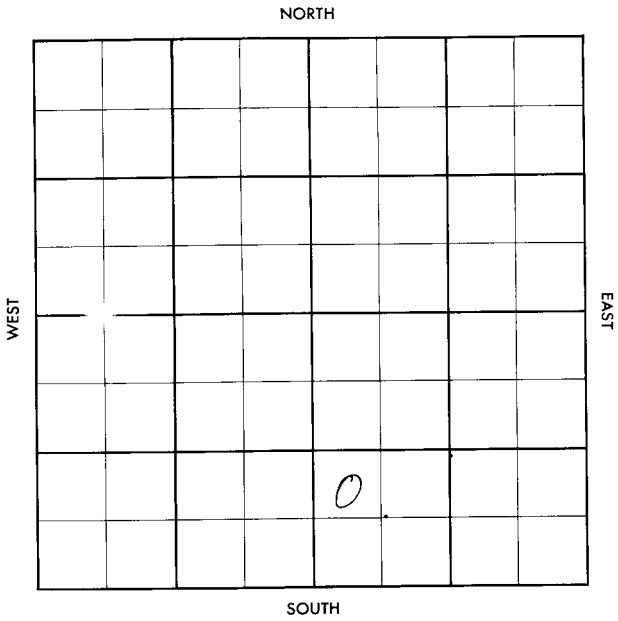

County SedgwickElev. 1288 RFSec. 12Twp. 29Rge. 1WCompany Geo. P. VyeFarm Name RexNo. 1

TOPS	DEPTH	LOG	DATUM	Loc. in Sec.
Anh.				NW SW SE
Tr.				
H.				
Tr.				
Dg.				
BL				
L.				
N.C.	<u>2743</u>			Geol. <u>Fremont</u>
BXC.				Conts.
Ce.				Prime Drlg.
C.				
M.	<u>3285</u>			Pool
M.				NW Brumley
K.				
Mz.				
Mo.				
V.				
S.				
S.				
A.				
R.				
PE.				
G.				
TD.	<u>3257</u>			

ABANDONED		
JAN	2	'57

Date Comm. Sun - farmoutMIR DEC 20 12-20-56 858264/200 ID 2165 JAN 2 '57DST 3290-3314 or 90" rec 105"GCM FP 55-65 BHP 740/15DST 3315-22 1hr rec 15' 50& GCM + 100' SW FP 35-35 BHP765/30D.E.A.