


Section 12 Township 29 Range 37WWell No. #1 GarterCompany Hugoton Prod.

NORTH

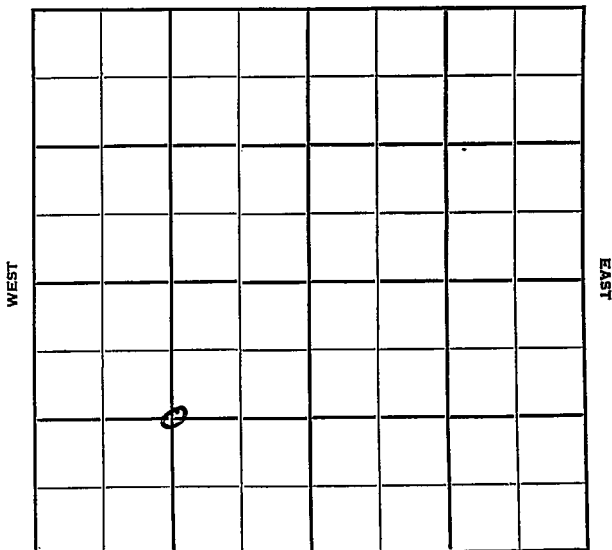

SOUTH

Grant

KANSAS

37W

Sec. 12 Twp. 29 R.

Well No. #1 Carter Farm

Hugoton Prod.

Company

Contractor

Ft. from N. Line

1320'


Ft. from S. Line

Ft. from E. Line

1320'

Ft. from W. Line

C SW/4

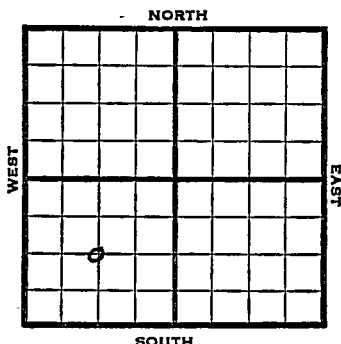

1952

Elev. 3006' REPORT

9/4

Spud 8-29-52

10" @ 560

Dr1g. 1159

9/10

RTD 2400 7" @ 2388 WOC

9/17

DD 2455' TD

9/24

NR

10/1

Spud 8-29-52

Gas Well TD 2612'

10" @ 560' 7" @ 2388'

TD 2612'

Hol. 2328

Her. 2377

Kri. 2392


Win. 2460

Ft. Riley 2520

Comp. 34,000,000 gas

COMPLETED

County Grant State Kansas
 Sec. 12 (Blk. Twp.) 29 (Sur. Rge.) 37W Map No.
 Operator Hugoton Prod.
 Well No. 1 Farm Carter
 Elev. _____ Location G SW/4

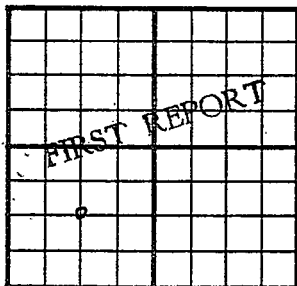

1320 Ft. From S Line SW

1320 Ft. From W Line Quarter

Ist. Report SEP 4 1952


Completion _____

Remarks _____

Spudding Date 8-29-52

Drlg. Data

10" @ 560 drlg. 1159

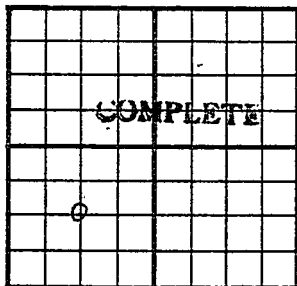County Grant State KansasSec. 12 (Blk. Twp.) 29 (Sur. Rge.) 37W Map No.Operator Hugoton Prod.Well No. 1 Farm CarterElev. 3006 Location C SW/41320Ft. From S Line SW1320Ft. From W Line Quarter

1st. Report

Completion OCT 1 1952

Remarks

Spudding Date 8-29-52Drig. Data Gas well TD 261210" @ 560 7" @ 2388 TD 2612Hol. 2328 Her. 2377 Kri. 2392Win. 2460 Ft. Riley 2520Comp. 34,000,000 gas