

No Record

KANSAS Grant

FORM 51 10M 7-48 PETROL

Section 12 Township 29 Range 38W


Well No. 1 Sullivan

Company Kansas Natural Gas

OWDD

Hugoton Pool

NORTH

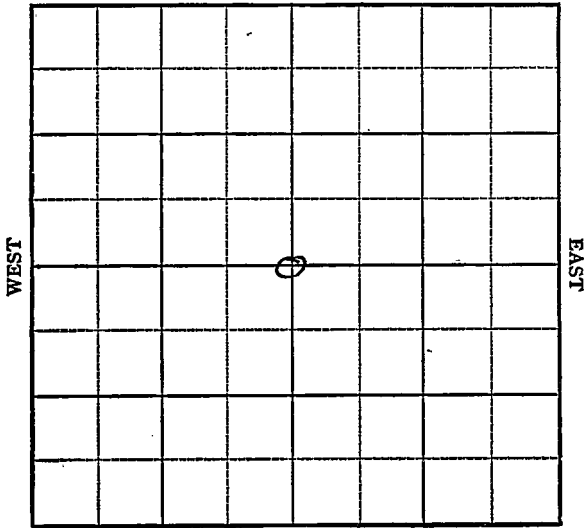

SOUTH

KANSAS

Sec. 12 Twp. 29 R. 38W

Well No. 1 Sullivan Farm

Kansas Natural Gas


Hugoton Pool Company

2640' Ft. from N. Line

_____ Ft. from S. Line

2640' Ft. from E. Line

_____ Ft. from W. Line

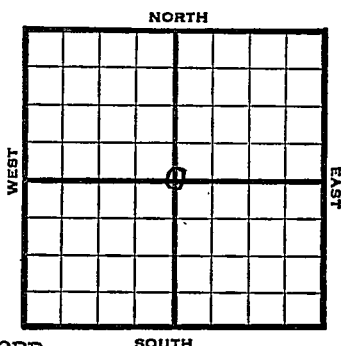

C Sec.

NO RECORD

SOUTH

1948

Eli 3058' REPORT

9/22

Location OWDD
Old Well Plugged

9/29

Drlg. 1680'

10/6

2" @ 2355'
Drlg. 2400'

10/13

TD 2569'
237' of 5" Perf liner @ 2569
Acid 6000

10/19

"

10/27

TD 2569'
7" @ 2355'
237' of 5" Perf liner @ 2569'
9000 acid
39,400,000 Gas
408# R Pr.
Comp

COMPLETED

Grant County Kansas StateMap No. _____ Sec. 12 Twp. 29 R. 38WWell No. 1 SullivanKansas Natural Gas Company

FIRST REPORT

Contractor

C Sec.


SECTION PLAT

2640 Ft. from N. Line

_____ Ft. from S. Line

2640 Ft. from E. Line

_____ Ft. from W. Line

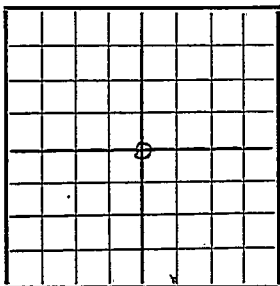Hugoton Pool

Remarks:

Location OWDD

Old well plugged

Date
SEP 22 1948

Scout

S. J. LEWIS

20170111

Pierce Flat Book_____

Map No. _____ Sec. 12 Twp. 29 R. 38W

Well No. 1 Sullivan

Kansas Natural Gas Company

COMPLETE

Contractor

C. Sec.

E12058


SECTION PLAT

2640 Ft. from N. Line

Ft. from S. Line

2640 Ft. from E. Line

Ft. from W. Line

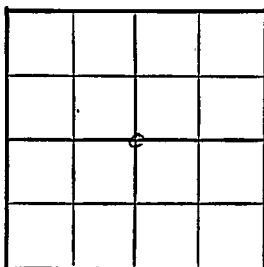

Grant County

Location

Rig up

Drilling and Remarks:

2" C2355
237' of 5" Casing
@ 25-68
9000 cu ft
39,400,000 gal
418 RB

RECORD

Cased _____ in., _____ ft.

Sand _____

Gas _____

Oil _____

Total Depth 2569

PRODUCTION

1st 24 hrs. Nat. _____

1st 24 hrs. after shot _____

Gas _____ Cu. Ft.

Dry Hole _____

Abandoned 0571

Date

OCT 27 1948

S. J. LEWIS Scout

1

10-10170-3

RECORD

Misc. Small Maps _____
Cards _____
Tracing _____
France Map _____
Scarborough Map _____
Pierce Map _____
Ecological Dept. _____
Pierce Plat Book _____