


Section 12 Township 29 Range 33W

Well No. #1 Frank McCoy

Company Kansas Natural Gas

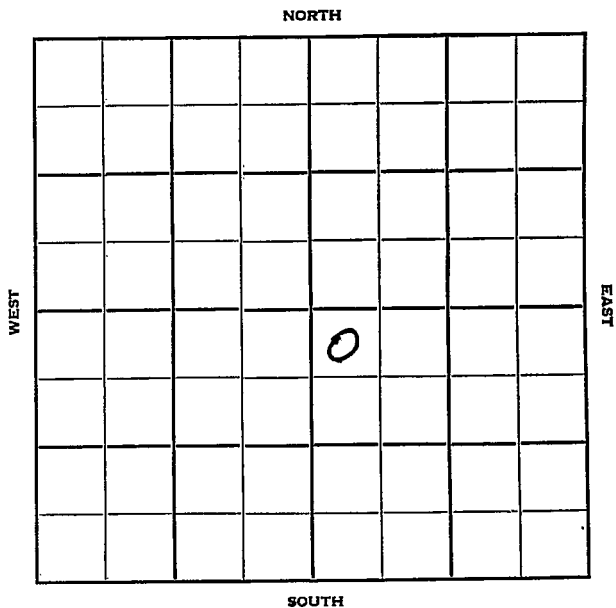

Sec. 12 Twp. 29 R. 33 W

Well No. # 1 Frank McCoy Farm

Kansas Natural Gas Company

Contractor

Hugoton


100 Ft. from N. Line

\_\_\_\_\_ Ft. from S. Line

\_\_\_\_\_ Ft. from E. Line

100 Ft. from W. Line

NW NW SE

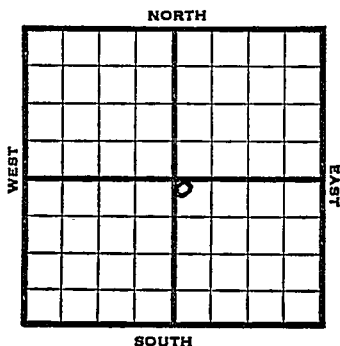

1952

Elev. 2930' REPORT

8/13

Spud 8-9-52  
8" @ 558'

8/20

7" @ 2730 RTD 2730

8/27

Winfield 2726 Her. 2650  
DD 2744' TD 48/ 2650-58  
96/ 2682-98 2500 A

9/3

12,000 A

9/10

NR

9/17

"

9/24

"

10/1

"

10/15

Spud Date: 8-9-52  
Drlg. Data: Gas Well TD 2744'  
8" @ 558  
Her 2650, Win. 2726  
TD 2744  
48/2650-58, 96/2682-98, 12000A  
Comp. 14,505,000 gas

**COMPLETED**

County **Haskell** State **Kansas**

Sec. **12** (Blk. Twp.) **29** (Sur. Rge.) **33W** Map No.

Operator **Kansas Natural Gas**

Well No. **1** Farm **Frank McCoy**

Elev. **2930** Location **NW NW SE**


FIRST REPORT

**100** Ft. From **N** Line **SE**

**100** Ft. From **W** Line Quarter

Ist. Report **AUG 13 1952**

Completion

Remarks

Spudding Date **8-9-52**

Drlg. Data **Hugoton**

**8" @ 558**

**J. G. McGEHEE**

