


35-29-13W

WELL LOG BUREAU—KANSAS GEOLOGICAL SOCIETY
508 East Murdock, Wichita, Kansas

Company- NATURAL GAS & OIL CO.
Farm- Larrison "A" No. 2

SEC. 35 T. 29 R. 13W
NW NE NW

Total Depth. 4600'
Comm. 4-3-59 Comp. 4-26-59
Shot or Treated.
Contractor. Sierra Petroleum Co.
Issued. 7-4-59

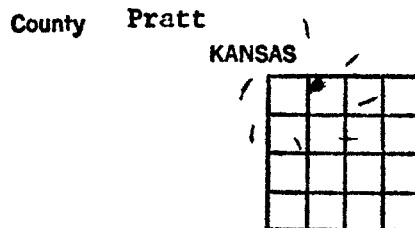

Elevation. 1863' KB

8 5/8" 852' cem w/600 sx.
5 1/2" 4599' cem w/170 sx.

Production. 2,300,000 CFG

Figures Indicate Bottom of Formations.

sand & clay	140
shale	240
shale & red bed	375
red bed	749
Anhydrite	770
shale & red bed	852
shale & shells	1235
shale & shells	1480
salt & shale	1615
shale & shells	1865
lime	2405
shale & lime	3080
lime	3300
lime & shale	3485
lime	3775
lime & shale	3879
lime	4331
lime & shale	4307
Viola	4420
lime	4435
chert, lime & shale	4474
lime & shale	4503½
lime	4533
Simpson sand	4600
Total Depth	

TOPS:

Heebner (scout)	3670
Douglas (scout)	3705
Lansing (scout)	3864
Conglomerate (scout)	4289
Misner Sand (scout)	4387
Viola (scout)	4397
Simpson Shale	4512
Simpson Sand	4533