


Kiowa

KANSAS

SECTION 13 TOWNSHIP 29 RANGE 18W

WELL NO. #1 Wilson

COMPANY Imperial Oil Co.

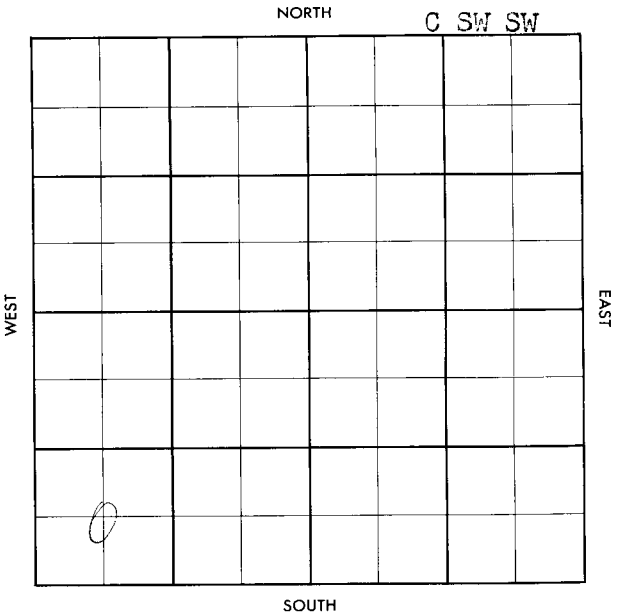

IOWA

SEC. 13	TWP. 29 S	R. 18 W
---	---	---

WELL NO. FAR

1 Wilson

COMPANY

Imperial Oil Co.

CONTRACTOR

Patton Drlg. Co.
Wildcat


_____ FT. FROM N. LINE

_____ FT. FROM S. LINE

_____ FT. FROM E. LINE

_____ FT. FROM W. LINE

C SW SW

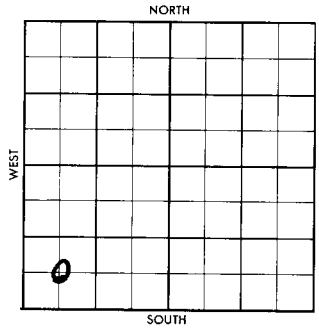

SDK-1/2 Mile

ELEVATION	REPORT
-----------	--------

1957	5/8 MIRT (PR Pkt)
------	--

FORM 513 SUNRAY

WILDCAT

County Kiowa

Elev. _____

Sec. 13Twp. 29Rge. 18WCompany Imperial Oil Co.Farm Name WilsonNo. 1

TOPS	DEPTH	LOG	DATUM	Loc. in Sec. _____
Anh.				<u>C SW SW</u>
Tp.				
H.				
Tr.				
Dg.				
Bl.				
L.				
K.C.				Geol. _____
BXC.				Comp. _____
Ce.				<u>Patton Drlg.</u>
C.				<u>Pool 14065</u>
M.				<u>Wildcat</u>
M.				
K.				
M.				
V.				
S.				
S.				
A.				
R.				
Pe.				
G.				
SD				

MAY 8 57

FIRST REPORT

1/2 mile

SDX

Date Comm. _____

MIRT

M.M.

Nichols

FORM 513 SUNRAY

County Kiowa Elev. 2193

Sec. 13 Twp. 29 Rge. 18W

Commercial Oil Co.

son

No. 1

TOPS	DEPTH	LOG	DATUM
Anb.			
Tr.			
H.			
Tr.			
Dg.			
Bl.			
L.			
K.C.	4281		
B.K.C.	4634		
Ce.	4821		
C.			
M.	4909		
M.			
K.			
Mz.			
Ma.			
V.			
S.			
S.			
A.			
R.			
Pe.			
G.			
TD	5040		

Loc. in Sec. _____

C SW SW

Geol. _____

Contr. _____

Patton Drlg.

Pool _____

Mildcet

ABANDONED

Date Comm. _____

May 15 '57

5-7-57 8 5/8 59 8

1400 DP 2800 DST 4284

-4300 up 1 hr 18' Md BHP

III DP 4334 DST 4846-4900

2 hrs rec 35' Md BHP 353/20

DST 4911-18 up 2 hrs rec

185' VSO & GCM BHP 865/20"

DST 4918-28 2 hrs rec 60'

VSO & GCM + 570' WT BHP 1372