

Pratt

KANSAS

SEC. 33	TWP. 29	R. 12W
------------	------------	-----------

WELL NO. #1 Thompson FAR

COMPANY Rupp-Ferguson

CONTRACTOR Co. Tools


WILDCAT

_____ FT. FROM N. LINE

_____ FT. FROM S. LINE

_____ FT. FROM E. LINE

_____ FT. FROM W. LINE

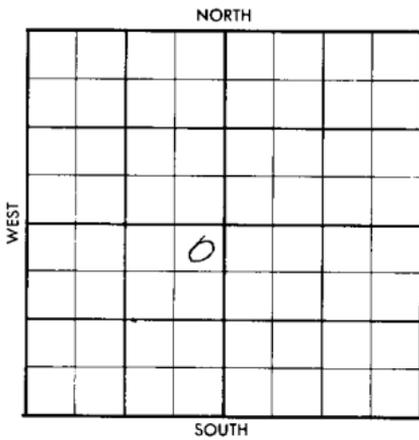

NE NE S W

CSO & Gulf- DHM

1956	ELEVATION 1886' RB	REPORT
------	--------------------	--------

7-3 Comm. 6-29-56
8" @ 370 w/250
Drlg. 2060

7-18 DST 3810-35 op 1 hr. rec. 260' MSW,
BHP 1290
DST 4305-20 op 1 hr rec. 20' drlg. mu
All press Off.
DST 4491-4506 op 1 hr. rec. 10' mud,
Press Off.
DST 4589-4601 op 1 hr. rec. 530' SW,
BHP 415/20"
D & A
H. 3611'; D. 3720'; Sp. sd. 3810';
L. 3871'; K. 4306'; X. 4342';
V. 4488'; W. 4589'; A. 4697';
TD 4710'

ABANDONED

County Pratt Elev. K1886 RB
 Sec. 13 Twp. 29 Rge. 12W
 Company Rupp-Ferguson
 Farm Name Thompson No. 1

TOPS	DEPTH	LOG	DATUM	Loc. in Sec.
Ant.				NE NE SW
Tr.				
H.	3681			
Dg.				
Dg. 119 sd	3720			
Bh.	3810			
L.	3871			Geol.
K.C.				Contr.
R.K.C.				Co. tools
Ce.				Pool
C.				Wildcat
M.	4306			<div style="border: 1px solid black; padding: 5px; text-align: center;"> BANDONED JUL 18 1956 </div>
M.				
K.	4342			
Ms.				
Ms.				
V.	4488			
S.	4589			
S.				
A.	4697			
R.				
PE.				
G.				
TD	4710			

Date Comm. 6-29-56 CSO & Gulf - D.M.
 8" @ 370/250 drlg. 2000 JUL 11 '56 X

Hb. 3681 Dg 3720 Dg sd. 3810 DST
 3810-35 in 1hr see 260' MSW
 BHP 1290 / L59 3891 @ 4109
 JUL 18 '56 DST 4305-20 1hr see
 20' @ Md All press @ DST
 4491-4506 1hr see 10' Md
 press @ DST 4589-4601 1hr see
 530' SW BHP 415/20" D & Q