


Pratt

KANSAS

SECTION 13 TOWNSHIP 29S RANGE 13W

WELL NO. #1 D. H. Thompson

COMPANY Texas Co.

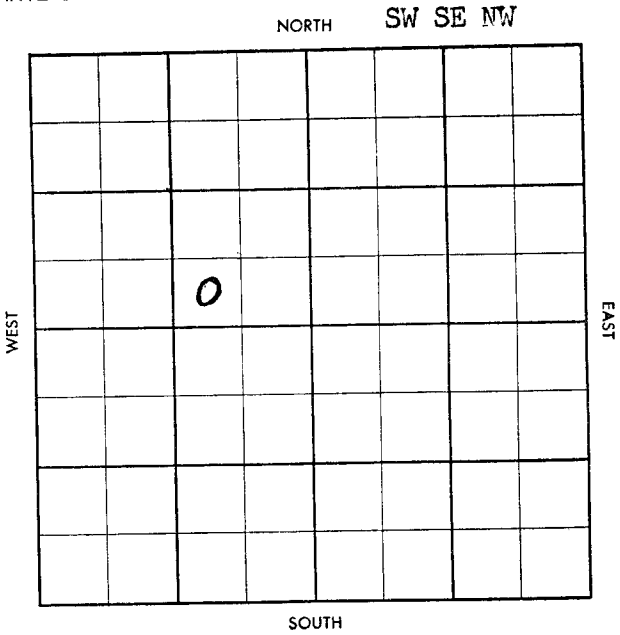

Twp. ~~29~~ East ~~13~~Co. ~~13~~ West ~~29~~

County Pratt Elev. _____
 Sec. 13 Twp. 29 Rge. 13W
 Company Texas Co.
 Farm Name D. H. Thompson No. 1

TOPS	DEPTH	LOG	DATUM
Anh.			
Tp.			
H.			
Tr.			
Dg.			
B.L.			
L.			
K.C.			
B.K.C.			
Ce.			
C.			
M.			
M.			
K.			
Mz.			
Mq.			
V.			
S.			
S.			
A.			
R.			
Pf.			
G.			
T.D.			

Loc. in Sec. _____


SW SE NW

Geol. _____

Contr. _____

Dowell Drilg.

Pool _____

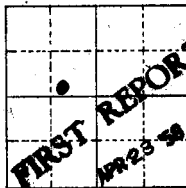

Date Comm. _____

Location

Twp. _____ Pool _____

Co. _____ Facet _____

5-513-B

County Pratt Elev 1923 OF 1926 RB
 Sec. 13 Twp. 29 Rge. 13W
 Company Texas Co.
 Form Name D. H. Thompson No. 1

TOPS	DEPTH	LOG	DATUM
Anh.			
Tp.			
H.	<u>3719</u>		
Tr.			
Dg.	<u>3752</u>		
B.L.	<u>3900</u>		
L.	<u>3916</u>		
K.C.			
B.K.C.			
Ce.			
C.			
M.	<u>4390</u>		
M.			
K.	<u>4408</u>		
Mz.			
Mq.			
V.	<u>4490</u>		
S.	<u>4598</u>		
S. <u>sd</u>	<u>4624</u>		
A.	<u>4706</u>		
R.			
Pf.			
G.			
T.D. <u>4745-4840</u>			

Loc. in Sec. _____
SW SE NW
 Geol. _____
 Contr. _____
Dowell Drlg.
 Pool _____

ABANDONED
 JUN 3 '58

Date Comm. 4-19-58
 Location NE 34 1/4 92 500
last cire c 1840 MAY 1 '58 SKID 50'
East Spud 5-358 Loss
line 916 MAY 14 '58 Ø 2765 MAY 21 '58
DST 4092-4122 1hr 1680' SW
BHP 1495-1480/30" DST 4188-4210
1hr 28' gcm 5 PKs oil BHP
1550-80/30 Ø 4282 MAY 28 '58 DST
4489-4531 1hr 28' gcm BHP 300'

DST 4592 - 4632 1hr 2230 SW
BHP 1410/20" 4 4720 JUN 3 58

D6 A

Fig 5-6 - tied
13-29-13W