


Section 13 Township 29 Range 14W

Well No. #1 Nellie

Company Lion Oil

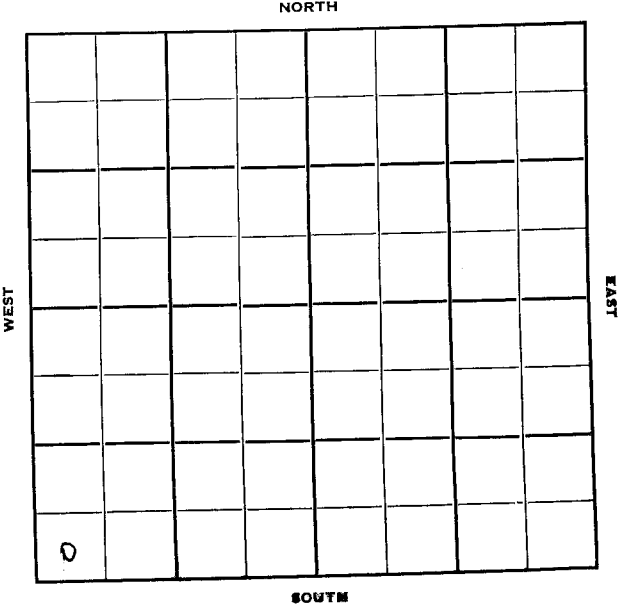

Sec. 13 Twp. 29 R. 14W

Well No. #1 Nellie Farm

Lion Oil Company

Rine Drlg. Contractor

Wildcat


Ft. from N. Line

330' Ft. from S. Line

Ft. from E. Line

330' Ft. from W. Line

SW SW SW

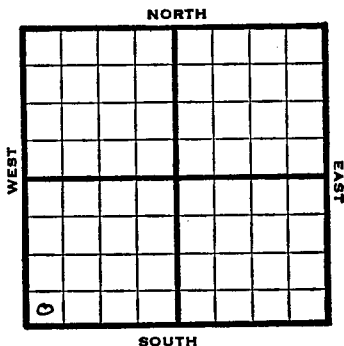

950	Elev 1937 REPORT
9/27	RUR
10/18	Spud 9-26-50
	8" @ 416
	Br line 3909
	Miss 4365
	Simp sh 4513
	Arb 4609
	TD 4654
	D&A
	ABANDONED
	Lans 3935
	Viola 4419
	Simp sd 4521



