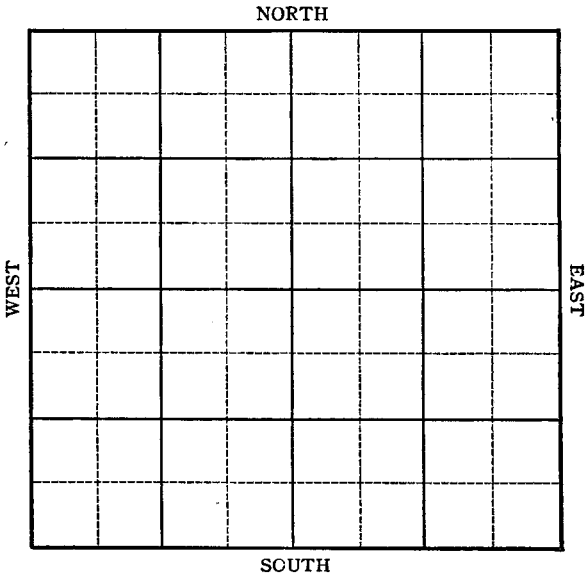


KANSAS

Section 13 Township 29 S Range 10 WWell No. #1 TheisCompany B & R DRLG.

KANSAS

Kingman County

Sec. 13 Twp. 29 R. 10W

Well No. #1 Theis Farm

B & R Drlg. Company

Wildcat


330 Ft. from N. Line

Ft. from S. Line

330 Ft. from E. Line

Ft. from W. Line

NE/c

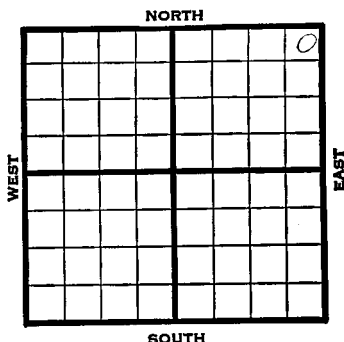

1945

REPORT

Elev. 1726

4/11

Drlg. 290'

4/20

Drlg. 2610'

4/27

8" @ 353

Lans 3668

Drlg. 3815

5/3

Miss

4232

B Miss

4362

Drlg. 4439

5/16

Arb

4700


TD 4733

ABANDONED

Kansas Pool Name WildcatMap No. 54 Sec. 13 Twp. 29 R. 10WWell No. 1 TheisB & R Drlg. CompanyFIRST REPORT Contractor

NE/c

SECTION PLAT

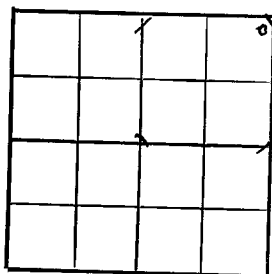330 Ft. from N. Line Ft. from S. Line330 Ft. from E. Line Ft. from W. Line

Kingman

Location Rig up

Drilling and Remarks:

290'

RECORD

Cased in., ft.Sand Gas Oil Total Depth

PRODUCTION

1st 24 hrs. Nat. 1st 24 hrs. after shot Gas Cu. Ft.Dry Hole Abandoned

Date

APR 1 1 1945 19S. J. [Signature] Scout

Kansas

Pool Name WildcatMap No. 54 Sec. 13 Twp. 29 R. 10WWell No. 1 TheisB & R Drlg.

Company

ABANDONED

Contractor

NE/c

E 1726

SECTION PLAT

330

Ft. from N. Line

Ft. from S. Line

330

Ft. from E. Line

Ft. from W. Line

			0

Kingsman County

Location

Rig up

Drilling and Remarks:

Cor 4700

RECORD

Cased _____ in., _____ ft.

Sand _____

Gas _____

Oil _____

Total Depth 4723

PRODUCTION

1st 24 hrs. Nat. _____

1st 24 hrs. after shot _____

Gas _____ Cu. Ft.

Dry Hole _____

Abandoned _____

Date

MAY 16 1945 19

S. J. LEWIS Scout