

Sedgwick

KANSAS

13

29


1W

SECTION _____ TOWNSHIP _____ RANGE _____

WELL NO. #1 Roy "B"

COMPANY Renfro etal

NORTH

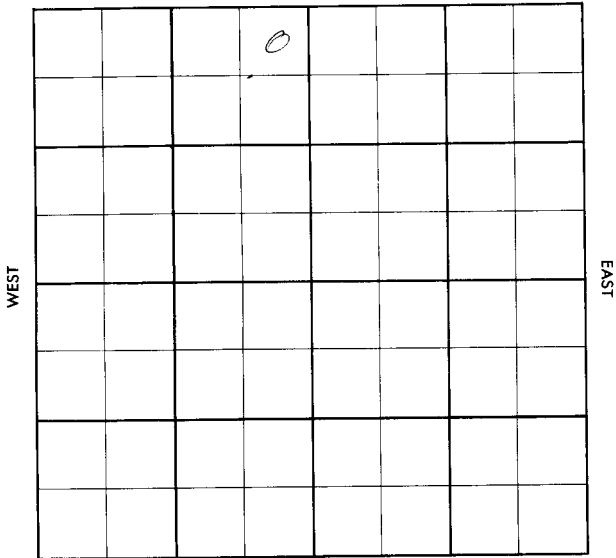

SOUTH

County **Sedgwick** Elev. _____
Sec. **13** Twp. **29S** Rge. **1W**
Company **Menfro et al**
Farm Name **Roy #3** No. **1**

TOPS	DEPTH	LOG	DATUM	Loc. in Sec.
Anh.				NE NE NW
Tr.				
Dg.				
Bl.				
L.				
K.C.				Geol. _____
B.K.C.				Contr. _____
Ce.				Co.
C.				
M.				Pool _____
M.				
K.				
Mz.				
Mo.				
V.				
S.				
S.				
A.				
R.				
Pe.				
G.				
ED				

FIRST REPORT
OCT 3 '56

Date Comm. **MINT**
28

CORRECTION

FORM 513 SUNRAY

County Sedgwick Elev. 1292 RB
 Sec. 13 Twp. 29 Rge. 1W
 Company Renfro et al
 Farm Name Roy No. 1

TOPS	DEPTH	LOG	DATUM	Loc in Sec.
Ant.				NE NE NW
Tp.				
H.				
Tr.				
Dg.				
Bl.				
L.				
K.C.	2750			Geol.
BXC.				Contr.
Ce.				
C.				Co.
M. <u>erro</u>	3317			Pool
M. <u>LI</u>	3321			
K.				
Mz.				
Mo.				
V.				
S.				
S.				
A.				
R.				
Pe.				
G.				
TD	3353			

ABANDONED
 OCT 17 '56

Date Comm. MIRT OCT 10 '56 10-1-56
1358 155/140 11 2915 OCT 17 '56
DST 3323-31 90" net. 60' 61R
+60' 508' GCM 0-90 BHP 460
120"
DEA