FORM 51 25M 3-49 PETROL


KANSAS

Sedgwick

Section 13 Township 29 Range 1W

Well No. 1 Roy

Company Kewanee Oil

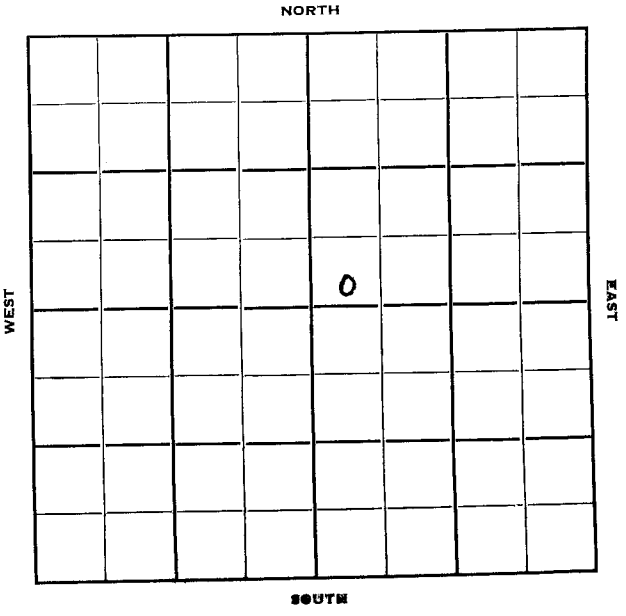

FORM 252-B

KANSAS ✓

Sedgwick

Sec. 13 Twp. 29 R. 1W

Well No. #1 Roy Farm

Kewanee Oil Company

Kewanee Contractor

Wildcat


Ft. from N. Line

330 Ft. from S. Line

Ft. from E. Line

330 Ft. from W. Line

SW SW NE

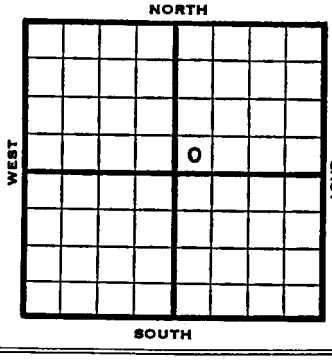

1952 Elev. 1285' REPORT

12/17 RUR

12/25 RUR

1/1 KC 2743 Drlg. 3075

1/8 DST 3318-36 1 Hr. 17,000 gas 75' O&GCM 100' MCO 975# Schl. 5" @ 3329 RTD 3336 CO 3336 10 GO 96 GWPH 6 Hrs.

1/22 Testing

1/29 Pulling pipe

2/5 "

2/12 NR

2/19 "

2/26 N.R.

3/4 Spud 12-15-52
D&A
TD 3355
8" @ 173
KC 2743
DST 3318-36, opn 1 hr., 17,000 gas, 75' o & gcm, 100' mco 975#
5" @ 3329
TD 3336, B/10 go 16 gwph 6 hrs. 500A S/70 bw 8 bopd DD 3355
PB 3339, 20/3320-25, CO to 3342
PB 3325, 1000A, S/5 bo 102 bw 12 hrs., CO to 3285 CO to 3355
S/all wtr. D&A

ABANDONED

FORM 275 FOR SALE BY KANSAS BLUE PRINT CO


County Sedgwick State Kansas

Sec. 13 (Blk. Twp.) 29 (Sur. Rge.) 1W Map No.

Operator Kewanee Oil

Well No. 1 Farm Roy

Elev. Location SW SW NE

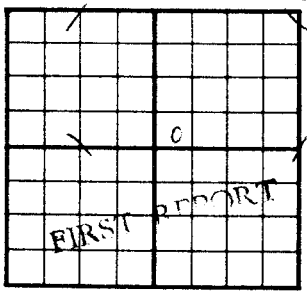

330 Ft. From S Line NE

330 Ft. From W Line Quarter

1st. Report DEC 17 1952

Completion

Remarks Kewanee - Contr.

Spudding Date

Drlg. Data Wildcat

R U R

J. G. [illegible]

FORM 275 FOR SALE BY KANSAS BLUE PRINT CO.


County Sedgwick State Kansas

Sec. 13 (Blk. Twp.) 29 (Sur. Rge.) 1W Map No.

Operator Kewanee Oil

Well No. 1 Farm Roy

Elev. 1285 Location SW SW NE

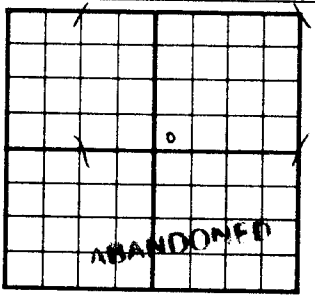

330 Ft. From S Line NE

330 Ft. From W Line Quarter

1st. Report

Completion MAR 4 1953

Remarks Wildcat

Kewanee - Contr.

Spudding Date 12-15-52

Drlg. Data D & A TD 3355

8" @ 173 KC 2743 DST 3318-36

open 1 hr. 17,000 gas 75' o. & gcm

100' mco 975# 5" @ 3329 TD 3336

B/ 10 go 16 gwph 6 hr. 500 A

S/ 70 bw 8 bopd DD 3355 PB 3339

20/ 3320-25 CO to 3342 PB 3325

1000 A S/ 5 bo 102 bw 12 hr.

CO to 3285 CO to 3355 S/ all wtr.

D & A

J. G. McGEHEE