

Sedgwick

KANSAS

13

29


LW

SECTION _____ TOWNSHIP _____ RANGE _____

WELL NO. #4 Emma Roy

COMPANY Newman Bros.

NORTH C W $\frac{1}{2}$ SF SW

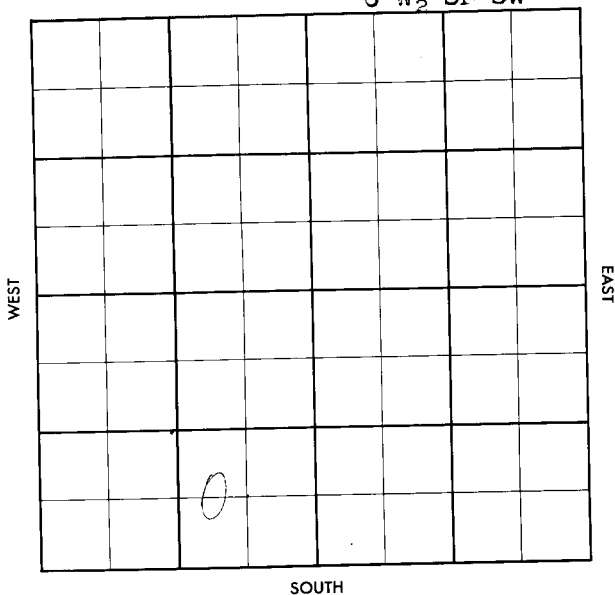

County Sedgewick Elev. _____
 Sec. 13 Twp. 29 Rge. 1W
 Company Hessman Bros.
 Farm Name Emma Roy No. 4

	TOPS	DEPTH	LOG	DATUM	Loc. in Sec.
Anh.					C $\frac{1}{2}$ SE SW
TP.					
H.					
Tr.					
Dg.					
Bl.					
L.					
K.C.					Geol. _____
B.K.C.					Contr. _____
Ce.					Frasier
C.					Pool _____
M.					W. Brunley
M.					
K.					
Nz.					
Mo.					
V.					
S.					
S.					
A.					
R.					
PE.					
G.					
TD.					

FIRST REPORT
 FEB 27 '57
 0

Date Comm. RUR

~~28~~

~~25~~ 25

County Sedwick Elev. 1282
 Sec. 13 Twp. 29 Rge. 1W
 Company Newman Bros.
 Farm Name Emma Roy No. 4

TOPS	DEPTH	LOG	DATUM	Loc. in Sec.
Ans				C W ¹ SE SW
Tr.				
H. <u>stain</u>	<u>2441</u>			
Tr.				
Dg.				
Bl.				
L.				
K.C.	<u>2769</u>			Geol.
B.K.C.	<u>2977</u>			Contr.
Ce.				
C.				<u>Frazier</u>
M. <u>chert</u>	<u>3345</u>			Pool
M. <u>Dolo</u>	<u>3354</u>			<u>W. Brumley</u>
K.	<u>3678</u>			
Mz.				
Me.				
V.				
S.	<u>3743</u>			
S.				
A.	<u>3807</u>			
R.				
PE.				
G.				
TD.	<u>3875</u>			

COMPLETE
 SEP 8 '57

Date Comm.

RUR MAR 6 '57 2-25-57 8578 @
 241/125 @ 2059 MAR 13 '57 @ 2992
 MAR 20 '57 @ 3721 MAR 27 '57 Pipe set
 APR 3 '57 APR 10 '57 APR 17 '57 4 1/2 @ 3810
 WOCT APR 24 '57 MAY 1 '57 To be SWD
 well. MAY 8 '57 ✓ MAY 15 '57 MAY 22 '57 ✓ MAY 29 '57
 JUN 5 '57 Kink in pipe @ 2640
 JUN 12 '57 JUN 19 '57 JUN 26 '57 JUL 3 '57 JUL 10 '57 JUL 17 '57
 JUL 24 '57 JUL 31 '57 AUG 8 '57 AUG 14 '57 AUG 21 '57 AUG 28 '57

13-39-1W

FORM 513-1 SUNRAY

SEP 25

SEP 11 57

24 BOPd from SIMPSON

SEP 18 57 413754-55 250A

POP PV 20 BOPd + 10 BWd

13-29-1W

w/2 se sw