


Haskell KANSAS
33W

Section 13 Township 29 Range 33W

Well No. #1 Wright

Company National Assoc. Pet.

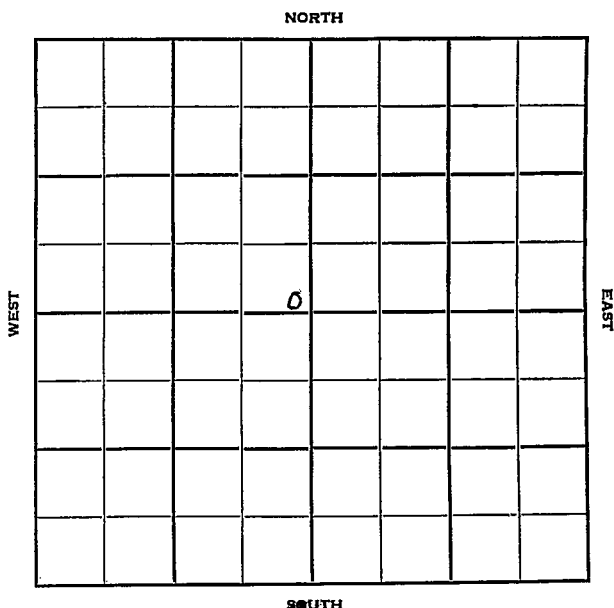

KANSAS

Sec. 13 Twp. 29 R. 33W Haskell

Well No. #1 Wright Farm

National Assoc. Pet. Company

Hugoton Pool Contractor


 Ft. from N. Line

100' Ft. from S. Line

100' Ft. from E. Line

 Ft. from W. Line

SE NW

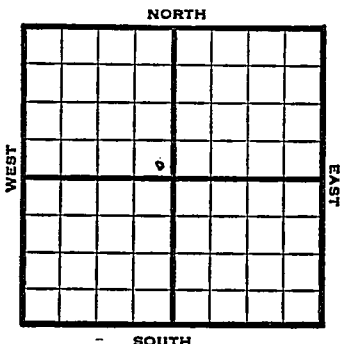

1950 Elev. 2928' REPORT

12/6 Location

1951

3/28 Location Abandoned.

ABANDONED



Sec. **13** (Blk. Twp.) **29** (Sur. Rge.) **33W** Map No.

Well No. 1 Farm Wright

Elev.	2928	Location	SE NW
-------	------	----------	-------

100Ft. From S Line NW

100Ft. From E Line Quarter

1st. Report DEC 6 1950

Completion

Remarks _____


Spudding Date _____

Drig. Data Higdon Pool

Location

J. E. TYRA

County Haskell State Kansas
 Sec. 13 (Blk. Twp.) 29 (Sur. Rge.) 33W Map No.
 Operator National Assoc. Pet.
 Well No. 1 Farm Wright
 Elev. 2928 Location SE NW

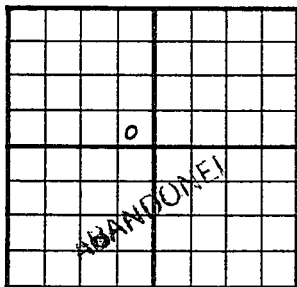

100 Ft. From S Line NW
100 Ft. From E Line Quarter

1st. Report

Completion MAR 28 1951

Remarks Hugoton Pool

Spudding Date

Drilg. Data

Location abd.

J. E. TYRA