


Section 11 Township 29 Range 9 W

Well No. # 1 Arensdorf

Company Cities Service Oil

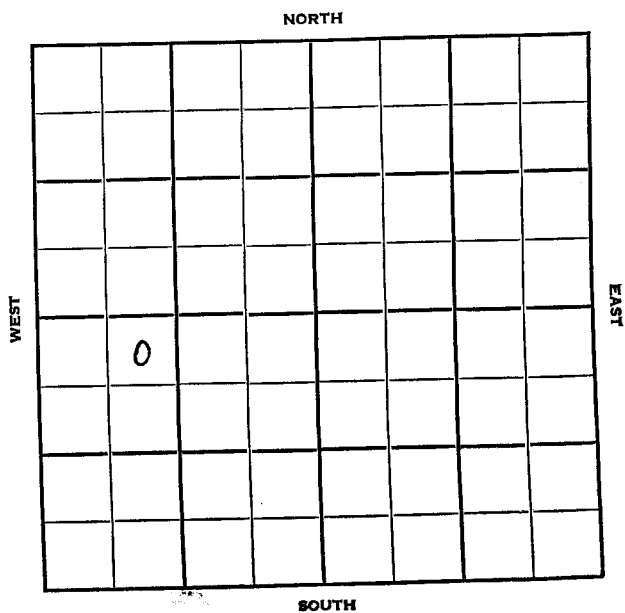

Kingman

SEC.	TWP.	R.
14	29	9 W

WELL NO.

1 Arensdorf

FARM

COMPANY

Cities Service Oil

CONTRACTOR

Barbour

Willowdale Pool


330 Ft. from N. Line

Ft. from S. Line

Ft. from E. Line

990 Ft. from W. Line

NE NW SW

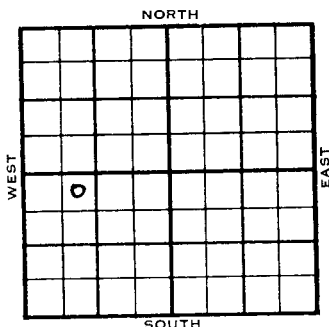

1955

ELEVATION

1667'

REPORT

1/12

MIR

6/8

Comm 1-12-55

H 3327, Tr Dodge 3343, Dg 3372, L
 3530, M 4179, V 4479, S sd 4532,
 A 4650, TD 5100

10" @ 311/225

DST 4180-95 open 1 hr Rec 124' mud

62' m & sw 1500/30" DST 4480-85

open 1 hr Rec 64' mud 47' ocm

15' m & sw 1350#


DST 4485-91 open 1 hr Rec 30' mud

150# TD 4663 7" @ 4663 DD 5100

Comp SWD well

COMPLETED

County Kingman State Kansas
 Sec. 14 (Blk. Twp.) 29 (Sur. Rge.) 9W Map No. _____
 Operator Cities Service Oil
 Well No. 1 Farm Arensdorf
 Elev. _____ Location NE NW SW

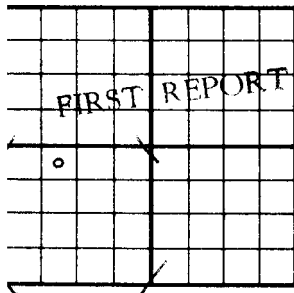

330 Ft. From N Line SW
990 Ft. From W Line Quarter
 Ist. Report JAN 1 2 1955

Completion _____

Remarks _____

Barbour - Contr.

Spudding Date _____

Orig. Data Willowdale Pool
M I R

County Kingman ✓ Elev. 1667
 Sec. 14 Twp. 29 Rge. 9W
 Company Cities Service
 Farm Name Arendsdorf No. 1

TOPS	DEPTH	LOG	DATUM	Loc. in Sec.
Anh.				NE NW SW
T.P.				
H.	3327		1660	
Tr. <u>Dodge</u>	3343		1676	
Dg.	3372		1705	
Bl.				
L.	3530	1 A	1863	Geol.
K.C.				Contr.
B.K.C.				Barbour
Ce.				Pool
C.				Willowdale
M.	4179		2512	
M.				
K.				
Mz.				
Me.				
V.	4479		2812	
S. <u>ad</u>	4532		2865	
S.				
A.	4650		2983	
R.				
Pe.				
G.				
TD.	5100			

Date Comm. 1-12-55

JUN 8 1955

10" @ 311/225 DST 4180-95 open 1 hr.

Rec. 124' mud 62' m & sw 1500/30"

DST 4480-85 open 1 hr. Rec. 64' mud

47' ocm 15' m & sw 1350#

DST 4485-91 open 1 hr. Rec. 30' mud

150# TD 4663 7" @ 4663 DD 5100

Comp. SWD well

ABANDONED