


ARIZONA

Section 14 Township 29 Range 9W

Well No. #1 Mueller

Company Aylward & Aurora

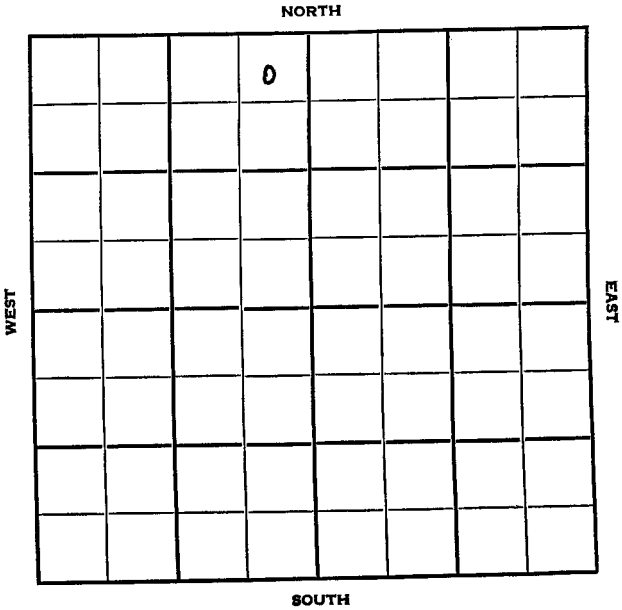

Kingman KANSAS

SEC.	TWP.	R.
14	29	9W

WELL NO. **1 Mueller** FARM

COMPANY **Aylward & Aurora**

CONTRACTOR **Aylward Drlg.**


Willow Dale Pool

330 Ft. from N. Line

_____ Ft. from S. Line

330 Ft. from E. Line

_____ Ft. from W. Line

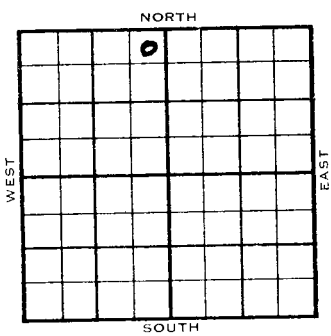

NE NE NW

	ELEVATION	REPORT
1954	1700'	

L 8/11	Location
11/23	<p>Spud 8-12-54 - Oil Well</p> <p>TD 4525'</p> <p>8" @ 164'</p> <p>Miss 4204'</p> <p>DST 4206-20', opn 2 hrs., rec. 150'</p> <p>gas, 55' O&GCM, 55' wtry mud, 0#</p> <p>Viola 4486'</p> <p>DST 4486-95', opn 1 hr., gas in 9",</p> <p>F/ oil in 42", 1570#</p> <p>TD 4520'</p> <p>5" @ 4520'</p> <p>CO 48/4486-96, FU 4000' oil 1 hr.,</p> <p>S/75 boph</p> <p>F/400 bo 24 hrs.</p> <p>Comp. F 230 bopd</p> <p>Schl Tops: Heeb 3338', Doug 3376',</p> <p>Lans 3562', Miss 4264', Viola 4485',</p> <p>TD 4525'</p>

COMPLETED


County Kingman State Kansas

Sec. 14 (Blk. Twp.) 29 (Sur. Rge.) 9W Map No.

Operator Aylward & Aurora

Well No. 1 Farm Mueller

Elev. _____ Location NE NE NW

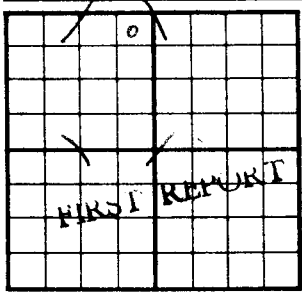

330 Ft. From N Line NW

330 Ft. From E Line Quarter

1st. Report AUG 11 1954

Completion _____

Remarks _____


Aylward Drlg. - Contr.

Spudding Date _____

Drlg. Data Willow Dale Pool

Location

County **Kingman** State **Kansas**
 Sec. **14** (Blk. Twp.) **29** (Sur. Rge.) **9W** Map No.
 Operator **Aylward & Aurora**
 Well No. **1** Farm **Mueller**
 Elev. **1700** Location **NE NE NW**

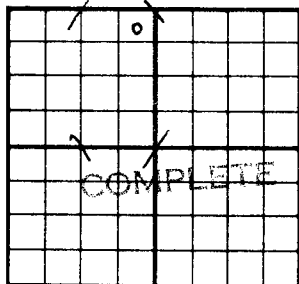

330 Ft. From **N** Line **NW**
330 Ft. From **E** Line **Quarter**

1st. Report

Completion **0V 03 1954**

Remarks **Willowdale Pool**
Aylward - Contr.

Spudding Date **8-12-54**

Drig. Data **Oil well** **TD 4525**

8" @ 164 **Miss. 4204** **DST 4206-20**

open 2 hr. **Rec. 150' gas** **55' o & gcm**

55' wtry mud **0#** **Viola 4486** **DST 4486-95**

open 1 hr. **gas in 9 min.** **F/ oil in 42 m**

1570# **TD 4520** **5" @ 4520** **CO**

48/ 4486-96 **FU 4000' oil** **1 hr.**

S/ 75 boph **F/ 400 bo** **24 hr.**

Comp. F/ 230 bopd

SCHLUMBERGER TOPS:

Heeb. 3338 **Doug. 3376** **Lans. 3562**

Miss. 4264 **Viola 4485** **TD 4525**

FAL... STRAP