


DX 78-1

Kingman KANSAS

Section 14 Township 29 Range 9 W

Well No. # 3 Mueller "C"

Company Cities Service

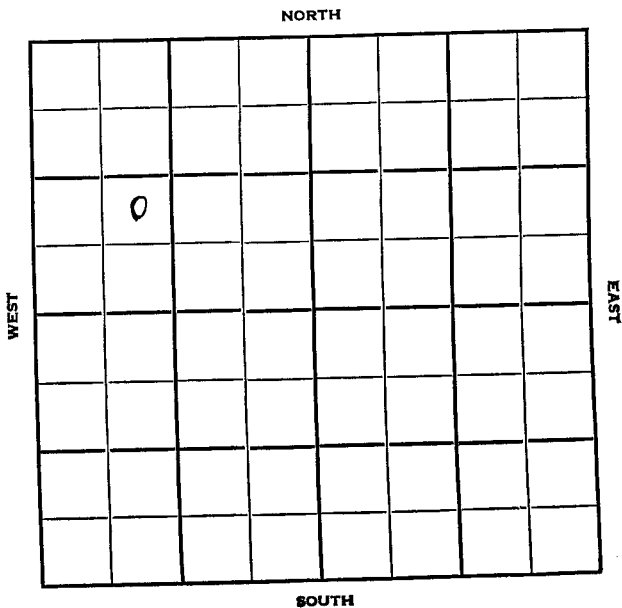

Kingman KANSAS

SEC.	TWP.	R.
14	29	9W

WELL NO. 3 Mueller "C" FARM

COMPANY Cities Service

CONTRACTOR Prime Drlg.


Willowdale Pool

_____ Ft. from N. Line

990 _____ Ft. from S. Line

_____ Ft. from E. Line

990 _____ Ft. from W. Line

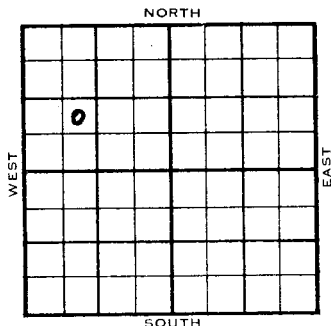

NE SW NW

1954	ELEVATION	REPORT
	1692'	
10/13	Spud 10-6-54	
	8" @ 310'	
	Drlg. 2675'	
11/23	Spud 10-6-54 - Oil Well	
	TD 4509'	
	8" @ 310'	
	Heeb 3342', D edge 3357', Mans 3550',	
	Doug. 3378', Miss 4194'	
	DST 4195-4214', opn 1 hr., gas in 15"	
	rec. 90' O&GCM, 400' W&GCO, 60' SW,	
	1350#	
	Kh. 4301', Viola 4478'	
	DST 4480-86', opn 1 hr., gas in 3",	
	248' MCO, 3348' oil, 1575#	
	TD 4509'	
	5" @ 4509'	
	CO to 4494'	
	21/4477-82, gas in 2 1/2 mins.,	
	FU 3627' oil 25",	
	F 120 bo 13 hrs.	
	Comp. F 291 bopd	
COMPLETED		

